

SURVEY & REMONUMENTATION

OTTAWA COUNTY REMONUMENTATION

APR 25 1995

LAND CORNER RECORDATION CERTIFICATE
Filing Requirement of Act 74, Mich. P.A. 1970

RECORDED

94 DEC -8 PM 12: 32

For corners in **COMMISSION OTTAWA**

Pauline Robinson
REGISTER OF DEEDS
OTTAWA COUNTY, MI

(County)	Located In:	Corner Code #
1. Public Land Survey	T 5N R 15W	L-11 (S 1/4 cor of Sec. 25) Holland Twp.
	T R	
	T R	
	T R	
	T R	
2. Property Controlling in Section	S T R	
	S T R	
3. Miscellaneous Property in Sec.	S T R	
	S T R	

Register of Deeds Stamp & File Number

4. Lot No. _____, Recorded Plat _____
5. Private Claims _____

	A	B	C	D	E	F	G	H	I	J	K	L	M
2	6	5	4	3	2	1							
3													
4	7	8	9	10	11	12							
5													
6	18	17	16	15	14	13							
7													
8	19	20	21	22	23	24							
9													
10	30	29	28	27	26	25							
11													
12	31	32	33	34	35	36							
13													

Randal J. Vugteveen, in a field survey on November 16, 1994

do hereby certify that under requirements of P.A. 74, Michigan P.A. of 1970, the corner points mentioned in lines 1 and 2 above were in conformance with regulations and rules therefore as required in the current manual of survey instructions of the United States Department of the Interior, Bureau of Land Management or by a decree of a Court of Law and/or that the corner points mentioned in lines 3, 4 and 5 above were in conformance with the rules of the Michigan Board of Land Surveyors or by a Decree of a Court of Law; established, re-established, monumented, re-monumented, recovered, found as expressed below:

NOTE: Not more than 4 corners, all in the same town and range, may be recorded on this certificate.

A. Description of original monument and accessories and/or subsequent restoration:

L-11 common corner to Sections 25 & 36	Liber 3, Page 363
1832 - Brookfield	Monument Box / Conc. edge bridge deck E
Set post	207.96' / NW cor bridge deck N80E 200.00' /
Beech 7" North 27 Links	NW cor conc. post @ SW cor bridge deck
Locus 7" S32W 15 Links	S80E 182.55'


3. Description of corner evidence found and/or method applied in restoring or reestablishing corner:

L-11 Found brass cap on iron in mon box on centerline Adams and accepted as a careful and faithful perpetuation of the position of the original corner	Monument Box
	Conc. edge bridge deck E 208.11'
	NW cor bridge deck N80E 199.95'
	NW cor conc post at SW cor bridge deck
	S80E 182.54'

PA. 345 OTTAWA COUNTY
PEER APPROVED 11/21/94
Robert P. Nedewold

C. Description of monument for corner and accessories established to perpetuate locating the position of the corner:

L-11 Removed iron set 3/4" X 24" solid rod in mon box with Ottawa County Remon Cap
Chisled "X" in SW corner 2.5 X 2.5' conc. guard rail anchor N26W 37.64'
Chisled "X" in NW corner 2.5 X 2.5 conc. guard rail anchor S37W 38.54'
SW corner conc post at NW corner bridge guard rail N83E 199.96'
NW corner conc. post at SW corner of bridge deck S80E 182.54'

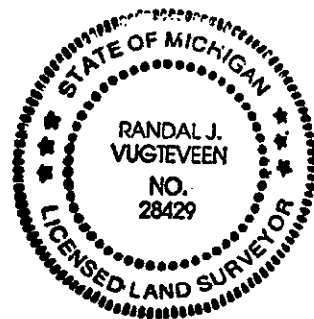

Signed by *Randal J. Vugteveen*
Surveyor's Michigan License No. 28429

Date Nov. 21, 1994