

RECORDED

97 JUL 24 PM 2:24

Ottawa County Remonumentation
LAND CORNER RECORDATION CERTIFICATE
Filing Requirement of Act 74, Mich. P.A. 1970

D. J. Harrison
REGISTER OF DEEDS
OTTAWA COUNTY, MI

For corners in
Ottawa
(County)

Located In: Corner Code #

1. Public Land Survey T 5N R 15W M-2 (E 1, 1)
T _____ R _____ Holland Twp.
T _____ R _____
T _____ R _____

2. Property Controlling S _____ T _____ R _____
in Section S _____ T _____ R _____

3. Miscellaneous S _____ T _____ R _____
Property in Sec. S _____ T _____ R _____

4. Lot No. _____, Recorded Plat _____

5. Private Claims _____

Register of Deeds Stamp & File Number

	A	B	C	D	E	F	G	H	I	J	K	L	M
2	6		5		4		3		2		1		
3													
4	7		8		9		10		11		12		
5													
6	18		17		16		15		14		13		
7													
8	19		20		21		22		23		24		
9													
10	30		29		28		27		26		25		
11													
12	31		32		33		34		35		36		
13													

I, John C. Bueche, in a field survey on November 4, 1996, do hereby certify that under requirements of P.A. 74, Michigan P.A. of 1970, the corner points mentioned in lines 1 and 2 above were in conformance with regulations and rules therefore as required in the current manual of survey instructions of the United States Department of the Interior, Bureau of Land Management or by a decree of a Court of Law and/or that the corner points mentioned in lines 3, 4 and 5 above were in conformance with the rules of the Michigan Board of Land Surveyors or by a Decree of a Court of Law; established, re-established, monumented, re-monumented, recovered, found as expressed below:

NOTE: Not more than 4 corners, all in the same town and range, may be recorded on this certificate.

A. Description of original monument and accessories and/or subsequent restoration:

M-2 GLO	LCRC L3, P340	LCRC L6, P3
Lucius Lyon,	Feb., 1979 1/2 sq. iron	Oct., 1989 Set CIM
DS, 1831	PP NE 74.50'	PK nail N side PP W 53.87'
Set HMP	TP W 53.84'	PK nail NW side PP NE 74.52'
Beech 12 N	NW cor. brick hse.	NW cor. hse. NE 97.07'
24 W 12	ENE 97.10'	W 1/4 cor. Sec. 6, 5-14 S 111.38'
W. Ash 9 S	Zeeland cor. S 111.46'	
56 W 32		

B. Description of corner evidence found and/or method applied in restoring or reestablishing corner:

M-2 Found Ottawa Co. Mon. (4" Harrison) in Mon. Box
As per above wit.

And is accepted as a careful and faithful perpetuation of the position of the original corner.

P.A. 345 OTTAWA COUNTY
PEER APPROVED 12-9-96


J. D. N.

C. Description of monument for corner and accessories established to perpetuate locating the position of the corner:

M-2 Ottawa Co. Mon. (4" Harrison) in Mon. Box
Nail & Ottawa Co. Remon. Tag in N side PP S 15° W 114.68'
Nail & Tag in NW side PP N 40° E 74.58'
SW cor. brick to garg. S 60° E 121.15'
NW cor. fnd. to hse. S 23° E 194.47'
NW cor. brick hse. N 80° E 97.07'
Ottawa Co. Mon. in Mon. Box, W 1/4 Sec. 6, 5-14 South 111.40'
On C/L bit. N-S, C/L bit. East, South 114'±
On field division West

Signed by John C. Bueche
John C. Bueche, P.S. 13027
Surveyor's Michigan License No.

Date 11-7-96

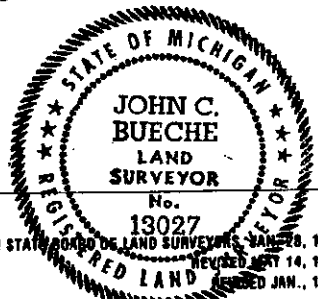

FORM APPROVED BY MICHIGAN STATE BOARD OF LAND SURVEYORS - JAN 28, 1971
REVISED MAY 14, 1975
RECEIVED JAN., 1983