

**SURVEY & REMONUMENTATION**

OTTAWA COUNTY REMONUMENTATION

RECORDED

APR 25 1995

LAND CORNER RECORDATION CERTIFICATE

94 DEC -8 PM 12:33

Filing Requirement of Act 74, Mich. P.A. 1970

For corners in **COMMISSION OTTAWA**

*Rodriguez*  
REGISTER OF DEEDS  
OTTAWA COUNTY, MI

(County)	Located In:	Corner Code #
1. Public Land Survey	T <u>5N</u> R <u>15W</u>	M-5 (SE cor of Sec. 12) Holland Twp
	T _____ R _____	_____
	T _____ R _____	_____
	T _____ R _____	_____
2. Property Controlling in Section	S _____ T _____ R _____	_____
	S _____ T _____ R _____	_____
3. Miscellaneous Property in Sec.	S _____ T _____ R _____	_____
	S _____ T _____ R _____	_____

Register of Deeds Stamp & File Number

4. Lot No. \_\_\_\_\_, Recorded Plat \_\_\_\_\_  
5. Private Claims \_\_\_\_\_

I, Randal J. Vugteveen, in a field survey on November 18, 1994

do hereby certify that under requirements of P.A. 74, Michigan P.A. of 1970, the corner points mentioned in lines 1 and 2 above were in conformance with regulations and rules therefore as required in the current manual of survey instructions of the United States Department of the Interior, Bureau of Land Management or by a decree of a Court of Law and/or that the corner points mentioned in lines 3, 4 and 5 above were in conformance with the rules of the Michigan Board of Land Surveyors or by a Decree of a Court of Law; established, re-established, monumented, re-monumented, recovered, found as expressed below:

**NOTE: Not more than 4 corners, all in the same town and range, may be recorded on this certificate.**

	A	B	C	D	E	F	G	H	I	J	K	L	M
2	6	5	4	3	2	1							
3													
4	7	8	9	10	11	12							
5													
6	18	17	16	15	14	13							
7													
8	19	20	21	22	23	24							
9													
10	30	29	28	27	26	25							
11													
12	31	32	33	34	35	36							
13													

**A. Description of original monument and accessories and/or subsequent restoration:**

M-5 common corner to Sections 12 & 13	Liber 1, Page 789	Liber 6, Page 4
1831 - Lyon & Sibley	Found Brass Plug	Set CIM
Set post	Cross in pavement Zealand cor S 55.00'	Nail N side TP WSW 39.24'
Beech 6" S23W 43 Links	Centerline pavement W 0.10'	Nail N side PP E 32.60'
Locus 6" N29 1/2W 26 Links		PK nail NE side SE 95.15'
		SW cor Sec. 7-5-14 S 54.98'

**B. Description of corner evidence found and/or method applied in restoring or reestablishing corner:**

M-5 Found CIM mon box on centerline 96th Avenue 55' North of centerline Riley and accepted as a careful and faithful perpetuation of the position of the original corner


CIM  
PK nail NE side 95.17'  
SW corner Sec. 7-5-14 S 55.03'

P.A. 345 OTTAWA COUNTY  
PEER APPROVED 11/21/94  
*Medy D. Nedeweld*

**C. Description of monument for corner and accessories established to perpetuate locating the position of the corner:**

M-5 Cast Iron Monument in Non Box

Top of hydrant S26E 94.97'  
Set Ottawa County Remon Tag & Nail N side P. pole West 38.92'  
Set Ottawa County Remon Tag & Nail N side P. pole East 32.23'  
Found CIM South 55.03' in mon box A-5 NW corner Section 18, T5N, R14W

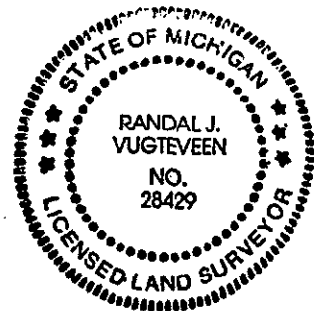

Signed by *Randal J. Vugteveen* Date Nov. 21, 1994  
Surveyor's Michigan License No. 28429