

**SURVEY &
REMONUMENTATION**

OTTAWA COUNTY REMONUMENTATION

APR 25 1995

RECORDED

COMMISSION

LAND CORNER RECORDATION CERTIFICATE 94 DEC -8 PM 12: 33
Filing Requirement of Act 74, Mich. P.A. 1970

corners in OTTAWA

Dorothy Robinson
REGISTER OF DEEDS
OTTAWA COUNTY, MI

(County)	Located In:	Corner Code #
Public Land Survey	T <u>5N</u> R <u>15W</u>	M-6 (E 1/4 cor of Sec 13) Holland Twp
	T _____ R _____	_____
	T _____ R _____	_____
	T _____ R _____	_____
Property Controlling in Section	S _____ T _____ R _____	_____
Miscellaneous	S _____ T _____ R _____	_____
Property in Sec.	S _____ T _____ R _____	_____

Register of Deeds Stamp & File Number

Lot No. _____, Recorded Plat _____
Private Claims _____

	A	B	C	D	E	F	G	H	I	J	K	L	M
2	6	5	4	3	2	1							
3													
4	7	8	9	10	11	12							
5													
6	18	17	16	15	14	13							
7													
8	19	20	21	22	23	24							
9													
10	30	29	28	27	26	25							
11													
12	31	32	33	34	35	36							
13													

Randal J. Vugteveen, in a field survey on November 18, 1994

do hereby certify that under requirements of P.A. 74, Michigan P.A. of 1970, the corner points mentioned in lines 1 and 2 above were in conformance with regulations and rules therefore as required in the current manual of survey instructions of the United States Department of the Interior, Bureau of Land Management or by a decree of a Court of Law and/or that the corner points mentioned in lines 3, 4 and 5 above were in conformance with the rules of the Michigan Board of Land Surveyors or by a Decree of a Court of Law; established, re-established, monumented, re-monumented, recovered, found as expressed below:

NOTE: Not more than 4 corners, all in the same town and range, may be recorded on this certificate.

Description of original monument and accessories and/or subsequent restoration:
M-6 common corner to Section 13

831 - Lyon & Sibley	Liber 1, Page 789
Set H.M.P.	Found iron pipe / Power pole SW 44.73' /
Each 10" S27W 32 Links	Power Pole SE 48.31' / Centerline hydrant
Ash 12" N15 1/2W 42 Links	WSW 53.68' / NW house corner SE 106.49' /
	Maple Stump NE 46.25' / 20" Maple NE
	79.45' / Zeeland Corner S 31.83' / SW
	house corner NE 105.64'

Description of corner evidence found and/or method applied in restoring or reestablishing corner:
M-6 Found 1/2" capped iron 4.7' E of centerline "X" of N. State St. & W. Roosevelt and accepted as a careful and faithful perpetuation of the position of the original corner


Centerline hydrant WSW 53.68'	
NW hse cor SE 106.40'	
36" Maple NE 80'	
Zeeland corner S 31.83'	

PA. 345 OTTAWA COUNTY
PEER APPROVED 11/21/94

Randal J. Vugteveen

Description of monument for corner and accessories established to perpetuate locating the position of the corner:
M-6 Removed 1/2" rebar, set 3/4" X 24" solid rod with Ottawa County Remon Cap in Mon Box

- Set Ottawa County Remon Tag & Nail in SW side P. Pole N48W 48.43'
- Top hydrant S66W 53.70'
- NE corner brick foundation of porch house #374 S38W 102.45'
- NW foundation corner house #373 S43W 106.40'
- Set Ottawa County Remon Tag & Nail in NW side P. pole N49E 46.56'

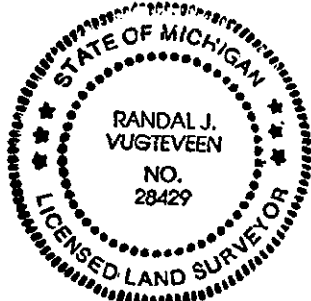

Signed by Randal J. Vugteveen
Surveyor's Michigan License No. 28429

Date Nov 21, 1994