

SURVEY & REMONUMENTATION

APR 25 1995

OTTAWA COUNTY REMONUMENTATION

RECORDED

COMMISSION

LAND CORNER RECORDATION CERTIFICATE

94 DEC -8 PM 12:33

Filing Requirement of Act 74, Mich. P.A. 1970

Phyllis Robinson
REGISTER OF DEEDS
OTTAWA COUNTY, MI

For corners in OTTAWA

	Located In:	Corner Code --#	
(County)			
1. Public Land Survey	T <u>5N</u> R <u>15W</u>	M-9 (SE cor of	
	T _____ R _____	Sec 24) Holland	
	T _____ R _____	Twp.	
	T _____ R _____		
2. Property Controlling	S _____ T _____ R _____		
in Section	S _____ T _____ R _____		
3. Miscellaneous	S _____ T _____ R _____		
Property in Sec.	S _____ T _____ R _____		

Register of Deeds Stamp & File Number

4. Lot No. _____, Recorded Plat _____
5. Private Claims _____

	A	B	C	D	E	F	G	H	I	J	K	L	M
2	6	5	4	3	2								
3													
4	7	8	9	10	11	12							
5													
6	18	17	16	15	14	13							
7													
8	19	20	21	22	23	24							
9													
10	30	29	28	27	26	25							
11													
12	31	32	33	34	35	36							
13													

I, Randal J. Vugteveen, in a field survey on November 18, 1994, do hereby certify that under requirements of P.A. 74, Michigan P.A. of 1970, the corner points mentioned in lines 1 and 2 above were in conformance with regulations and rules therefore as required in the current manual of survey instructions of the United States Department of the Interior, Bureau of Land Management or by a decree of a Court of Law and/or that the corner points mentioned in lines 3, 4 and 5 above were in conformance with the rules of the Michigan Board of Land Surveyors or by a Decree of a Court of Law; established, re-established, monumented, re-monumented, recovered, found as expressed below:

NOTE: Not more than 4 corners, all in the same town and range, may be recorded on this certificate.

A. Description of original monument and accessories and/or subsequent restoration:

M-9 common corner to Sections 24 & 25		
1831 - Lyon & Sibley Set post Beech 8" N14W 30 Links Hemlock 7" S25W 27 Links	Liber 2, Page 277 Found RR spike MSHD T. pole SW 51.90' PP E 33.70 PP NW 53.25' Zealand cor S 24.0'	Liber 3, Page 307 Found Steel bar in mon box PP NW 53.97' PP SW 51.90' PP E 34.42' NW cor Sec 30, T5N, R14W S 24.03'

3. Description of corner evidence found and/or method applied in restoring or reestablishing corner:

M-9 Found 1/2" rebar in mon box 1.5' W of 96th Ave and 1.0' S Perry St. to the West and accepted as a careful and faithful perpetuation of the position of the original corner

Exxel capped iron in mon box S 24.02'	NW 53.87' Pk SW side PP
	E 34.45' Pk S side PP
	NE 43.34' Pk NW side PP
	SE 59.49' Pk NE side PP
	SW 51.94' Pk N side PP

RA. 345 OTTAWA COUNTY
PEER APPROVED 11/21/94

Randal J. Vugteveen

C. Description of monument for corner and accessories established to perpetuate locating the position of the corner:

M-9 Removed 1/2" rebar, set 3/4" X 24" solid rod with Ottawa County Remon Can in mon box


NE corner brick house #1585 S52W 94.77'

Set Ottawa County Remon Tag & Nail in NE side P. pole N60W 52.12'

Top hydrant N37E 52.13'

Set Ottawa County Remon Tag & Nail in NE side guide pole S35E 59.50'

A-9 NW corner Section 30, Zealand Township S 24.02'

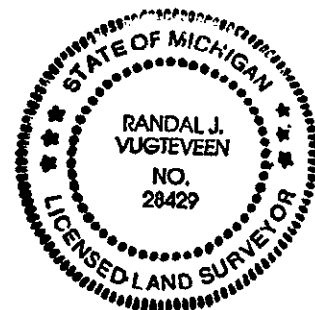

Signed by *Randal J. Vugteveen*
Surveyor's Michigan License No. 28429

Date Nov. 21, 1994