

SURVEY & REMONUMENTATION

OTTAWA COUNTY REMONUMENTATION

APR 25 1995

LAND CORNER RECORDATION CERTIFICATE

Filing Requirement of Act 74, Mich. P.A. 1970

RECORDED

94 DEC -8 PM 12:33

COMMISSION

or corners in OTTAWA

R. J. Vugteveen
REGISTER OF DEEDS
OTTAWA COUNTY, MI

(County)	Located In:	Corner Code #
Public Land Survey	T <u>5N</u> R <u>15W</u>	M-10 (E 1/4 cor of Sec 25) Holland Twp.
	T _____ R _____	_____
	T _____ R _____	_____
	T _____ R _____	_____
Property Controlling in Section	S _____ T _____ R _____	_____
Miscellaneous	S _____ T _____ R _____	_____
Property in Sec.	S _____ T _____ R _____	_____

Register of Deeds Stamp & File Number

Lot No. _____, Recorded Plat _____
Private Claims _____

	A	B	C	D	E	F	G	H	I	J	K	L	M
2	6		5		4		3		2		1		
3													
4	7		8		9		10		11		12		
5													
6	18		17		16		15		14		13		
7													
8	19		20		21		22		23		24		
9													
10	30		29		28		27		26		25		
11													
12	31		32		33		34		35		36		
13													

Randal J. Vugteveen in a field survey on November 17, 1994

I hereby certify that under requirements of P.A. 74, Michigan P.A. of 1970, the corner points mentioned in lines 1 and 2 above were in conformance with regulations and rules therefore as required in the current manual of survey instructions of the United States Department of the Interior, Bureau of Land Management or by a decree of a Court of Law and/or that the corner points mentioned in lines 3, 4 and 5 above were in conformance with the rules of the Michigan Board of Land Surveyors or by a Decree of a Court of Law; established, re-established, monumented, re-monumented, recovered, found as expressed below:

NOTE: Not more than 4 corners, all in the same town and range, may be recorded on this certificate.

Description of original monument and accessories and/or subsequent restoration:
1-10 common corner to Section 25

1831 - Lyon & Sibley	Liber 3, Page 215	Liber 3, Page 304
Set H.M.P.	T. pole SE 45.60'	Found iron pipe
Iron Lock 26" N75W 2 Links	PP W 48.11'	T. pole SE 45.60'
Sycamore 14" S25W 28 Links	40" Sycamore NNW 104.30'	PP W 48.11'
Field as Common Corners per T5N, R14W Gov't	24" Cherry SSW 79.56'	40" Sycamore NNW 104.30'
Notes by Sylvester Sibley		24" Cherry SSW 79.56'

Description of corner evidence found and/or method applied in restoring or reestablishing corner:
1-10 Found 3/4" iron in mon box at centerline "K" of 96th Ave & Woodbridge St. and accepted as a careful and faithful perpetuation of the position of the original corner


PP W 48.11'	Iron Pipe	3/4" pipe
40" Sycamore NNW 104.30'	P. pole W 48.04'	NW cor brk house S561/2E 103.91'
Common Corners per LCRC		NE cor hse fndn S751/2W 98.10'
Liber 3, Page 216		
Liber 3, Page 257		

PA 345 OTTAWA COUNTY
PEER APPROVED 11/21/94

Randal J. Vugteveen

Description of monument for corner and accessories established to perpetuate locating the position of the corner:
M-10 Removed 3/4" pipe, set 3/4" X 24' solid rod with Ottawa County Remon Cap in mon box

- NW corner brick house #1200 S60E 103.91'
- NE corner brick foundation house #1203 S75W 98.10'
- SE corner brick foundation house #1227 N45W 131.22'
- Top of hydrant N40E 49.47'

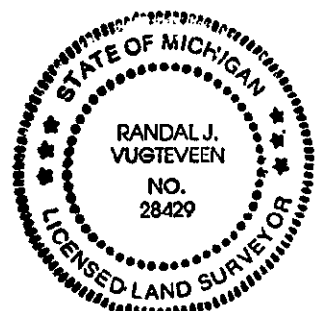

Signed by Randal J. Vugteveen

Date Nov 21, 1994

Surveyor's Michigan License No. 28429