

SURVEY & REMONUMENTATION

APR 25 1995

OTTAWA COUNTY REMONUMENTATION

RECORDED

COMMISSION

LAND CORNER RECORDATION CERTIFICATE

94 DEC -8 PM 12:32

Filing Requirement of Act 74, Mich. P.A. 1970

Dorothy K. Robinson
REGISTER OF DEEDS
OTTAWA COUNTY, MI

corners in OTTAWA
(County)

Located in: Corner Code #
Public Land Survey T 5N R 15W M-11 (SE cor of
T R Sec 25) Holland
T R Twp.
T R
T R
Property Controlling S T R
in Section S T R
Miscellaneous S T R
Property in Sec. S T R

Register of Deeds Stamp & File Number

Lot No. _____, Recorded Plat _____
Private Claims _____

| | | | | | | | | | | | | | |
|----|----|----|----|----|----|----|---|---|---|---|---|---|---|
| | A | B | C | D | E | F | G | H | I | J | K | L | M |
| 2 | 6 | 5 | 4 | 3 | 2 | 1 | | | | | | | |
| 3 | | | | | | | | | | | | | |
| 4 | 7 | 8 | 9 | 10 | 11 | 12 | | | | | | | |
| 5 | | | | | | | | | | | | | |
| 6 | 18 | 17 | 16 | 15 | 14 | 13 | | | | | | | |
| 7 | | | | | | | | | | | | | |
| 8 | 19 | 20 | 21 | 22 | 23 | 24 | | | | | | | |
| 9 | | | | | | | | | | | | | |
| 10 | 30 | 29 | 28 | 27 | 26 | 25 | | | | | | | |
| 11 | | | | | | | | | | | | | |
| 12 | 31 | 32 | 33 | 34 | 35 | 36 | | | | | | | |
| 13 | | | | | | | | | | | | | |

Randal J. Vugteveen in a field survey on November 16, 1994

hereby certify that under requirements of P.A. 74, Michigan P.A. of 1970, the corner points mentioned in lines 1 and 2 above were in conformance with regulations and rules therefore as required in the current manual of survey instructions of the United States Department of the Interior, Bureau of Land Management or by a decree of a Court of Law and/or that the corner points mentioned in lines 3, 4 and 5 above were in conformance with the rules of the Michigan Board of Land Surveyors or by a Decree of a Court of Law; established, re-established, monumented, re-monumented, recovered, found as pressed below:

NOTE: Not more than 4 corners, all in the same town and range, may be recorded on this certificate.

Description of original monument and accessories and/or subsequent restoration:

-11 common corner to Sections 25 & 36
831 - Lyon & Sibley | Liber 6, Page 250
at post | 3/4" iron in mon box
each 8" N52W 25 Links | Nail in SE face of PP NE 61.27'
unlock 7" S15W 42 Links | Nail in E face of PP NW 69.91'
held as Common Corner per T5N, R14W Gov't | Nail in SW face of guy pole SE 50.59'
notes by Sylvester Sibley | Nail in SE face of 12" Ash SW 54.00'


Description of corner evidence found and/or method applied in restoring or reestablishing corner:
-11 Found 3/4" pipe in mon box at centerline "X" of 96th & Adams St. and accepted as a careful and faithful perpetuation of the position of the original corner

3/4" iron in mon box
Nail in SE face of P. pole NE 61.31'
Nail in E face of P. pole NW 69.99'
held as Common Corner per Witnesses on:
Liber 1, Page 605
Liber 3, Page 256
Liber 5, Page 293

P.A. 345 OTTAWA COUNTY
PEER APPROVED 11/21/94
Randal J. Vugteveen

Description of monument for corner and accessories established to perpetuate locating the position of the corner:
-11 Removed pipe, set 3/4" X 24" solid rod in mon box with Ottawa County Remon Cap

Top hydrant S37E 79.54'
Set Ottawa County Remon Tag & Nail in SE side P. pole N42E 61.32'
Set Ottawa County Remon Tag & Nail in SW side P. Pole N45W 69.98'
NE corner concrete slab on porch to house #791 S43W 109.55'

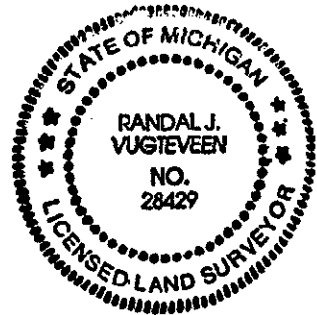

Signed by *Randal J. Vugteveen*
Surveyor's Michigan License No. 28429

Date Nov 21, 1994