

SURVEY & REMONUMENTATION

OTTAWA COUNTY REMONUMENTATION

RECORDED

APR 25 1995

LAND CORNER RECORDATION CERTIFICATE 94 DEC -8 PM 12:32

COMMISSION

Filing Requirement of Act 74, Mich. P.A. 1970

For corners in OTTAWA

Phyllis Bellman
REGISTER OF DEEDS
OTTAWA COUNTY, MI

(County)	Located In:	Corner Code #	
1. Public Land Survey	T <u>5N</u> R <u>15W</u>		M-12 (E 1/4 of Sec 36) Holland Twp.
	T _____ R _____		_____
	T _____ R _____		_____
	T _____ R _____		_____
2. Property Controlling in Section	S _____ T _____ R _____		_____
	S _____ T _____ R _____		_____
3. Miscellaneous Property in Sec.	S _____ T _____ R _____		_____
	S _____ T _____ R _____		_____

Register of Deeds Stamp & File Number

4. Lot No. _____, Recorded Plat _____
5. Private Claims _____

Randal J. Vugteveen, in a field survey on November 16, 1994, do hereby certify that under requirements of P.A. 74, Michigan P.A. of 1970, the corner points mentioned in lines 1 and 2 above were in conformance with regulations and rules therefore as required in the current manual of survey instructions of the United States Department of the Interior, Bureau of Land Management or by a decree of a Court of Law and/or that the corner points mentioned in lines 3, 4 and 5 above were in conformance with the rules of the Michigan Board of Land Surveyors or by a Decree of a Court of Law; established, re-established, monumented, re-monumented, recovered, found as expressed below:

	A	B	C	D	E	F	G	H	I	J	K	L	M
2	6	5	4	3	2	1							
3													
4	7	8	9	10	11	12							
5													
6	18	17	16	15	14	13							
7													
8	19	20	21	22	23	24							
9													
10	30	29	28	27	26	25							
11													
12	31	32	33	34	35	36							
13													

NOTE: Not more than 4 corners, all in the same town and range, may be recorded on this certificate.

A. Description of original monument and accessories and/or subsequent restoration:

M-12	Liber 3, Page 316
1831 - Lyon & Sibley	Found "T" iron
Set H.M.P.	126.69' 24" Maple N10 $\frac{1}{2}$ W
Sugar 12" S69W 7 Links	104.76' SW hse cor N80 $\frac{1}{2}$ E
Ironwood 7" N11W 16 Links	32.37' PP S75 $\frac{1}{2}$ E
Held as Common Corner per T5N, R14W Gov't	51.04' PP S75 $\frac{1}{2}$ W
Notes by Sylvester Sibley	


3. Description of corner evidence found and/or method applied in restoring or reestablishing corner:
M-12 Found "T" iron in mon box on centerline 96th and accepted as a careful and faithful perpetuation of the position of the original corner
104.76' SW hse Cor N80E
32.37' P. pole S75E
Common Corner to A-12, Zeeland Township per LCRC, Liber 3, Page 106

A. 345 OTTAWA COUNTY
PEER APPROVED 11/21/94
Madison D. Redmond

C. Description of monument for corner and accessories established to perpetuate locating the position of the corner:

M-12 Set 3/4" X 24" solid rod in mon box with Ottawa County Remon Cap

SW corner brick house #416 N80E 104.72'
Set Ottawa County Remon Tag & nail in N side P. pole S75E 32.26'
Top hydrant East 33.33'
Set Ottawa County Remon Tag & Nail in E side 36" Maple N10W 125.42'
Set Ottawa County Remon Tag & Nail in N side P. pole S73W 51.91'
Set Ottawa County Remon Tag & Nail on W side 24" Maple S21E 137.85'
Mon Box South 304.28'

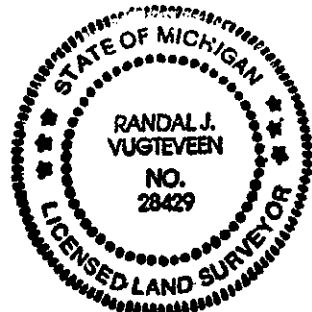

Signed by *Randal J. Vugteveen*
Surveyor's Michigan License No. 28429

Date Nov 21, 1994