

Ottawa County Remonumentation
 LAND CORNER RECORDATION CERTIFICATE
 Filing Requirement of Act 74, Mich. P.A. 1970

RECORDED

97 JUL 24 PM 2: 24

Robert J. Coleman
 REGISTER OF DEEDS
 OTTAWA COUNTY, MI

| For corners in | Located In: | Corner Code # |
|------------------------------------|-------------|---------------|
| Ottawa (County) | | |
| 1. Public Land Survey | T 5N R 16W | G-1 |
| | T R | Park Twp. |
| | T R | NW CORNER |
| | T R | SECTION 3 |
| 2. Property Controlling in Section | S T R | |
| 3. Miscellaneous Property in Sec. | S T R | |

Register of Deeds Stamp & File Number

4. Lot No. _____, Recorded Plat _____
 5. Private Claims _____

I, Steven Lampen, in a field survey on November 8 19 96, do hereby certify that under requirements of P.A. 74, Michigan P.A. of 1970, the corner points mentioned in lines 1 and 2 above were in conformance with regulations and rules therefore as required in the current manual of survey instructions of the United States Department of the Interior, Bureau of Land Management or by a decree of a Court of Law and/or that the corner points mentioned in lines 3, 4 and 5 above were in conformance with the rules of the Michigan Board of Land Surveyors or by a Decree of a Court of Law, established, re-established, monumented, re-monumented, recovered, found as expressed below:

| | A | B | C | D | E | F | G | H | I | J | K | L | M |
|----|----|----|----|----|----|----|---|---|---|---|---|---|---|
| 1 | | | | | | | 9 | | | | | | |
| 2 | 6 | 5 | 4 | 3 | 2 | 1 | | | | | | | |
| 3 | | | | | | | | | | | | | |
| 4 | 7 | 8 | 9 | 10 | 11 | 12 | | | | | | | |
| 5 | | | | | | | | | | | | | |
| 6 | 18 | 17 | 16 | 15 | 14 | 13 | | | | | | | |
| 7 | | | | | | | | | | | | | |
| 8 | 19 | 20 | 21 | 22 | 23 | 24 | | | | | | | |
| 9 | | | | | | | | | | | | | |
| 10 | 30 | 29 | 28 | 27 | 26 | 25 | | | | | | | |
| 11 | | | | | | | | | | | | | |
| 12 | 31 | 32 | 33 | 34 | 35 | 36 | | | | | | | |
| 13 | | | | | | | | | | | | | |

NOTE: Not more than 4 corners, all in the same town and range, may be recorded on this certificate.

A. Description of original monument and accessories and/or subsequent restoration:

| | | |
|---|--|--|
| G-1 GLO Brookfield, 1832 North boundary 1.42 west of post & set cor Beech 24 S 10 W 17 Hamlock 7 S 51 E 23 | G-1 is not recorded G-13, T6N R16W L1 P347-1972 Park corner W 90.43 | Cast iron monument Holland Engineering 1979-unrecorded SE cor Sec. 33-6-16 E 90.46 Cor fc. post SE 40.44 |
| | | Cast iron monument Holland Engineering 1983-unrecorded #14091 S side 10" Maple SE 71.84 #14091 W side 24" Maple SSE 87.82 #14091 SE side 10" Pine SW 96.97 |

B. Description of corner evidence found and/or method applied in restoring or reestablishing corner:

| | |
|---|---|
| G-1 Found cast iron monument in monument box SE cor Sec. 33-6-16 E 90.46 Cor fc. post SE 40.44 | #14091 S side 10" Maple SE 71.84 #14091 W side 24" Maple SSE 87.82 #14091 SE side 10" Pine SW 96.97 |
|---|---|

Established corner at intersection of W. line Section 3 with the South line of Section 33 T6N R16W and accepted it as a careful and faithful perpetuation of the position of the original corner.


P.A. 345 OTTAWA COUNTY
 PEER APPROVED 12-9-96

S.D.N.

C. Description of monument for corner and accessories established to perpetuate locating the position of the corner:

G-1 established corner at intersection of W line Section 3 with South line Section 33, T.6N., R.16W.
 Az.=Michigan State Plane grid direction

| | | |
|---|------------|-------|
| Centerline east and west asphalt road pavement | N | 0 |
| Cast iron monument in monument box | 182°33'15" | 0.535 |
| Remon. tag SW face PP | 310°54' | 46.20 |
| Remon. tag SE face 10" Pine | 216°00' | 97.40 |
| Remon. tag SW face 12" Maple | 128°45' | 72.30 |
| Remon. tag SW face 32" Maple | 164°45' | 88.95 |
| G-13, T6N, R16W = cast iron monument in mon box | 90°36' | 90.41 |

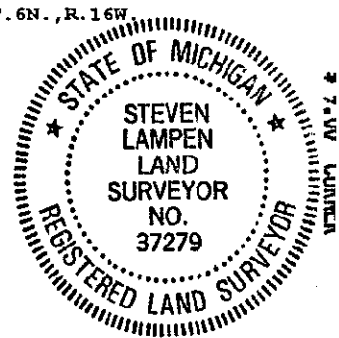

Signed by Steven Lampen Date November 11, 1996
 Surveyor's Michigan License No. 37279