

OTTAWA COUNTY REMONUMENTATION

1893

LAND CORNER RECORDATION CERTIFICATE
Filing Requirement of Act 74, Mich. P.A. 1970

David R. Greer
REGISTER OF DEEDS
OTTAWA COUNTY, MI

COMMISSION

For corners in
Ottawa
(County)


Located In:

Corner Code #

1. Public Land Survey	T	5N	R	16W	G-3 (NW Sec 10)
	T		R		Park Twp.
	T		R		
	T		R		
2. Property Controlling in Section	S		T	R	
	S		T	R	
3. Miscellaneous Property in Sec.	S		T	R	
	S		T	R	

Register of Deeds Stamp & File Number

4. Lot No. _____, Recorded Plat _____
5. Private Claims _____

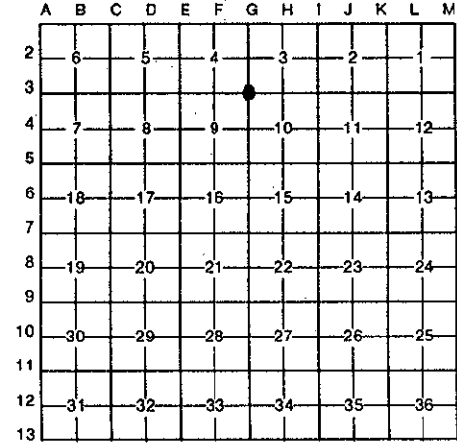

I, **David R. Greer**, in a field survey on **September 15**, 19 **93**, do hereby certify that under requirements of P.A. 74, Michigan P.A. of 1970, the corner points mentioned in lines 1 and 2 above were in conformance with regulations and rules therefore as required in the current manual of survey instructions of the United States Department of the Interior, Bureau of Land Management or by a decree of a Court of Law and/or that the corner points mentioned in lines 3, 4 and 5 above were in conformance with the rules of the Michigan Board of Land Surveyors or by a Decree of a Court of Law; established, re-established, monumented, re-monumented, recovered, found as expressed below:

NOTE: Not more than 4 corners, all in the same town and range, may be recorded on this certificate.

A. Description of original monument and accessories and/or subsequent restoration:

Recorded in Liber 1, Page 289

March 8, 1972 G-3

Found "T" Iron

12" Cherry	SW	69.95'
40" Cherry	NW	64.60'
12" Maple	NE	77.23'

Recorded in Liber 2, Page 533

August 12, 1974 G-3

"T" Iron in Mon. Box.

NW Cor School	S45°E	118.75'
44" Cherry	N60°W	66.10'
14" Maple	N25°E	77.29'
16" Beech	S65°W	72.68'

Recorded in Liber 5, Page 112

June 27, 1984 G-3

Cast Iron Monument

Con. Mon.	SW	46.45'
Light Pole	NW	36.33'
15" Maple	NNE	77.76'
Triple 10" Maple	ENE	67.19'

B. Description of corner evidence found and/or method applied in restoring or reestablishing corner:

G-3

Found cast iron monument and accepted it as a careful and faithful perpetuation of the position of the original corner

Light Pole	NW	36.33'
15" Maple	NNE	77.76'
Triple 10" Maple	ENE	67.19'
NW Cor School	S45°E	118.75'
14" Maple	N25°E	77.92'
44" Cherry	N60°W	66.10'

C. Description of monument for corner and accessories established to perpetuate locating the position of the corner:

G-3

Found broken C.I.M. in monument box. Set Ottawa County Remonumentation Iron & Cap.

AZ - Michigan State Grid Direction

NE Cor House Brick	AZ.	229°32'	118.06'
NW Cor Church Brick	AZ.	131°57'	118.72'
O.C. Remon tag & nail in SE Side Triple 12" Maple	AZ.	67°27'	67.10'
O.C. Remon tag & nail in E Side Power Pole	AZ.	342°48'	100.68'

Signed by *David R. Greer*

Date **9/15/93**

Surveyor's Michigan License No. **16042**

