

**OTTAWA COUNTY REMONUMENTATION  
LAND CORNER RECORDATION CERTIFICATE**  
Filing Requirement of Act 74, Mich. P.A. 1970

For corners in

<u>Ottawa</u> (County)	Located In:	Corner Code #
1. Public Land Survey	T 5N R 16W	G-12
	T R	East 1/4 corner
	T R	Section 33
	T R	Park Twp.
2. Property Controlling in Section	S 33 T 5N R 16W	
3. Miscellaneous Property in Sec.	S T R	
	S T R	

**RECORDED**  
96 DEC 20 PM 12:20

*Richard Robinson*  
REGISTER OF DEEDS  
OTTAWA COUNTY, MI

Register of Deeds Stamp & File Number

4. Lot No. \_\_\_\_\_, Recorded Plat \_\_\_\_\_  
5. Private Claims \_\_\_\_\_

I, Steven Lampen, in a field survey on December 6 19 96, do hereby certify that under requirements of P.A. 74, Michigan P.A. of 1970, the corner points mentioned in lines 1 and 2 above were in conformance with regulations and rules therefore as required in the current manual of survey instructions of the United States Department of the Interior, Bureau of Land Management or by a decree of a Court of Law and/or that the corner points mentioned in lines 3, 4 and 5 above were in conformance with the rules of the Michigan Board of Land Surveyors or by a Decree of a Court of Law; established, re-established, monumented, re-monumented, recovered, found as expressed below:

A	B	C	D	E	F	G	H	I	J	K	L	M
1												
2	6	5	4	3	2	1						
3												
4	7	8	9	10	11	12						
5												
6	18	17	16	15	14	13						
7												
8	19	20	21	22	23	24						
9												
10	30	29	28	27	26	25						
11												
12	31	32	33	34	35	36						
13												

**NOTE: Not more than 4 corners, all in the same town and range, may be recorded on this certificate.**

**A. Description of original monument and accessories and/or subsequent restoration:**

G-12 GLO-Brookfield 1832 North between Sec. 33 and 34 21.16 Block River Lake and set meander post 40.00 1/2 mile post in lake 69.60 left lake and set post 80.00 set cor to Sec. 27, 28, 33 and 34	Section line between Sections 33 and 34 running north from G-13 is shown on plat of Jenison's Park-1892 Section line between Sections 33 and 34 running south from G-11 is shown on the plat of Bayview-1924 and on Heneveld's Supervisor's Plat No.29-1935
--	--


**B. Description of corner evidence found and/or method applied in restoring or reestablishing corner:**

G-12 Found no field evidence or survey record that G-12 had ever been located since the original GLO survey. Calculated position of G-12 and the section line between Sections 33 and 34 by using the plats listed in part A for east and west location and proportioned the GLO measurement for north and south locations. See sketch on back. Set Ottawa County Remonumentation Irons and Caps as reference monuments at the intersection of the section line with the centerline of South Shore Drive (plat=Division St.) and at the GLO meander post on the north side of Lake Macatawa, south of G-11.

Calculated position of G-12 and the section line between Sections 33 and 34 are accepted as a careful and faithful re-establishment of the position of the original corner and section line.

**P.A. 345 OTTAWA COUNTY**  
**PEER APPROVED 12-9-96**

*S. D. M.*

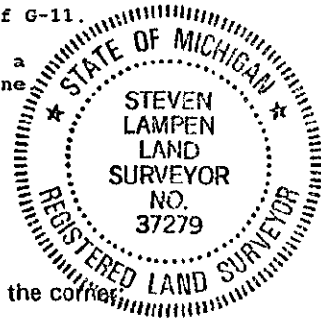

**C. Description of monument for corner and accessories established to perpetuate locating the position of the corner:**

Reference monument Ottawa County Remonumentation Iron and Cap in (set) monument box at the intersection of the east line of Section 33 with the centerline of South Shore Drive.	Reference monument Ottawa County Remonumentation Iron and Cap at the GLO meander post position between Sections 33 and 34 on the north side of Lake Macatawa
Hydrant, top centerline 37°54' 51.26	Hydrant, top centerline 13°41' 117.62
Remon tag in SE side tw. 16" maple 235°26' 68.20	Remon tag east side power pole 338°08' 70.17
NW corner building 140°27' 105.18	Remon tag NW side power pole 208°54' 37.02
N.O.S. b.m. 7031F 1980 272°07' 235.41	Remon tag North side power pole 65°10' 29.72
Centerline e & w asphalt road pavement 0°27' 5.5	Centerline Ottawa Beach Road 180°09' 29.60
G-13=remon iron in mon box 180°27'16" 657.91	North Shore Lake Macatawa 0°09'06" 122
GLO meander post position 0°27'16" 765.25	G-11,=remon iron in mon box 0°09'06" 699.47
	G-12, calculated position 180°15'08" 1990.81

\$ 1.00 PHOTO  
\$ 1.00 PHOTO

Signed by Steven Lampen Date DECEMBER 13, 1996

Surveyor's Michigan License No. 37279

FORM APPROVED BY MICHIGAN STATE BOARD OF LAND SURVEYORS, JAN. 28, 1971  
REVISED MAY 14, 1976  
REVISED JAN., 1983  
ADAPTED FOR WORD PROCESSING MARCH, 1993

