

RECORDED

Ottawa County Remonumentation
LAND CORNER RECORDATION CERTIFICATE

97 JUL 24 PM 2:25

Filing Requirement of Act 74, Mich. P.A. 1970

Register of Deeds
REGISTER OF DEEDS
OTTAWA COUNTY, MI

For corners in

<u>Ottawa</u> (County)	Located In:	Corner Code #
1. Public Land Survey	T 5N R 16W	H-1
	T _____ R _____	Park Twp.
	T _____ R _____	NORTH 1/4 CORNER
	T _____ R _____	SECTION 3
2. Property Controlling in Section	S _____ T _____ R _____	
	S _____ T _____ R _____	
3. Miscellaneous Property in Sec.	S _____ T _____ R _____	
	S _____ T _____ R _____	

Register of Deeds Stamp & File Number

4. Lot No. _____, Recorded Plat _____
5. Private Claims _____

I, Steven Lampen, in a field survey on Nov. 11 1996, do hereby certify that under requirements of P.A. 74, Michigan P.A. of 1970, the corner points mentioned in lines 1 and 2 above were in conformance with regulations and rules therefore as required in the current manual of survey instructions of the United States Department of the Interior, Bureau of Land Management or by a decree of a Court of Law and/or that the corner points mentioned in lines 3, 4 and 5 above were in conformance with the rules of the Michigan Board of Land Surveyors or by a Decree of a Court of Law; established, re-established, monumented, re-monumented, recovered, found as expressed below:

NOTE: Not more than 4 corners, all in the same town and range, may be recorded on this certificate.

A. Description of original monument and accessories and/or subsequent restoration:

H-1
GLO-corner not set by GLO survey

L5 P100 1983
Found "T" iron, set cast iron monument
Port Sheldon Twp. cor E 50.48
28" Maple SW 54.09
Twin 6" Cherry SE 56.51
12" Pine N 70.33
P.P. NE 95.36

B. Description of corner evidence found and/or method applied in restoring or reestablishing corner:

H-1
Found cast iron monument in monument box
Port Sheldon Twp. cor E 50.48
28" Maple SW 54.09
Twin 6" Cherry SE 56.51
12" Pine N 70.33

P.A. 345 OTTAWA COUNTY
PEER APPROVED 12-9-96


S.D.N.

This corner not monumented by original GLO survey. This monument is accepted as the best available evidence of the position of the corner. Established corner at intersection of N & S 1/4 line of Section 34 T6N, R16W.

C. Description of monument for corner and accessories established to perpetuate locating the position of the corner:

H-1
Established corner at intersection of N & S 1/4 line Section 3 with the South line of Section 34 T6N, R16W. Az.=Michigan State Plane Grid Direction

Centerline east and west asphalt road pavement	N	0
Cast iron monument in monument box	1°56'	0.09
H-13, T6N, R16W-CIM in mon. box	90°07'	50.44
Mid-point G-1 and I-1	270°07'	7.66
Remon tag in SE side 14" Pine	226°30'	116.50
Remon tag in SW side 12" Maple	298°56'	89.72
Remon tag in East side 12" Pine	357°21'	70.34
Remon tag in SW side power pole	106°08'	82.99

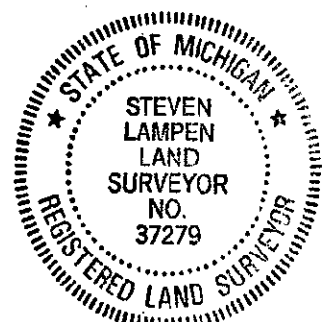

Signed by Steven Lampen Date November 11, 1996

Surveyor's Michigan License No. 37279

