

1993

OTTAWA COUNTY REMONUMENTATION

RECORDED

93 NOV -8 PM 1:53

COMMISSION

LAND CORNER RECORDATION CERTIFICATE  
Filing Requirement of Act 74, Mich. P.A. 1970


*Debbie Hollman*  
REGISTER OF DEEDS  
OTTAWA COUNTY, MI

For corners in  
Ottawa

(County)	Located In:	Corner Code #
1. Public Land Survey	T <u>5N</u> R <u>16W</u>	H-5 (S 1/4 Sec 10) Park Twp.
	T _____ R _____	_____
	T _____ R _____	_____
	T _____ R _____	_____
2. Property Controlling in Section	S _____ T _____ R _____	_____
	S _____ T _____ R _____	_____
3. Miscellaneous Property in Sec.	S _____ T _____ R _____	_____
	S _____ T _____ R _____	_____
4. Lot No. _____, Recorded Plat _____		
5. Private Claims _____		

Register of Deeds Stamp & File Number

I, David R. Greer, in a field survey on September 15, 19 93, do hereby certify that under requirements of P.A. 74, Michigan P.A. of 1970, the corner points mentioned in lines 1 and 2 above were in conformance with regulations and rules therefore as required in the current manual of survey instructions of the United States Department of the Interior, Bureau of Land Management or by a decree of a Court of Law and/or that the corner points mentioned in lines 3, 4 and 5 above were in conformance with the rules of the Michigan Board of Land Surveyors or by a Decree of a Court of Law; established, re-established, monumented, re-monumented, recovered, found as expressed below:

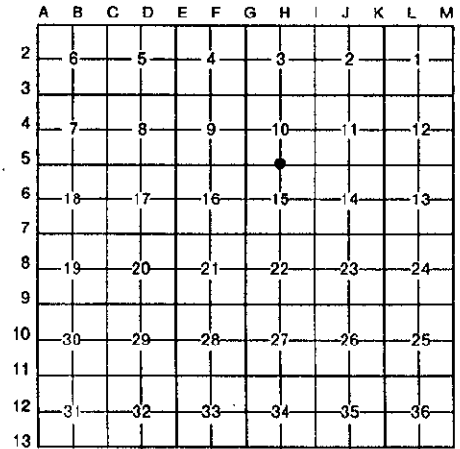

NOTE: Not more than 4 corners, all in the same town and range, may be recorded on this certificate.

A. Description of original monument and accessories and/or subsequent restoration:

- Recorded in Liber 1 Page 227 Jan. 11, 1972
- H-5
- Found Railroad Spike Set Cast Iron Monument inscribed Ottawa County Section Corner
- Angle Iron N 33.00'
- Nail in face of 6" Black Oak NW 66.65'
- Nail in face of 10" Twin Cherry SW 68.97'
- Nail in face of 8" Triple Cherry NE 118.34'
- Nail in face of 6" Pine SE 56.83'

B. Description of corner evidence found and/or method applied in restoring or reestablishing corner:

- H-5
- Found steel bar and accepted it as a careful and faithful perpetuation of the position of the original corner
- Nail in face of 10" Twin Cherry SW 68.97'
- Nail in face of 8" Triple Cherry NE 118.34'
- Nail in face of 6" Pine SE 56.83'

C. Description of monument for corner and accessories established to perpetuate locating the position of the corner:

- H-5
- Found Steel Bar. Set Ottawa County Remonument Iron & Cap
- AZ - Michigan State Grid Direction
- O.C. Remon tag & nail in W Side 10" Pine AZ. 171°47' 46.19'
- O.C. Remon tag & nail in NW Side 10" Twin Cherry AZ. 242°40' 68.40'
- SE House Cor, Brick AZ. 339°15' 192.74'
- SW Cor Garage Foundation AZ. 10°30' 133.08'

Signed by David R Greer Date 9/15/93  
Surveyor's Michigan License No. 16042

