

**OTTAWA COUNTY REMONUMENTATION
LAND CORNER RECORDATION CERTIFICATE**

Filing Requirement of Act 74, Mich. P.A. 1970

For corners in

<u>Ottawa</u> (County)	Located In:	Corner Code #
1. Public Land Survey	T 5N R 16W	H-11
	T _____ R _____	South 1/4
	T _____ R _____	corner
	T _____ R _____	Section 27
2. Property Controlling in Section	S 29 T 5N R 16W	Park Twp.
	S _____ T _____ R _____	
3. Miscellaneous Property in Sec.	S _____ T _____ R _____	
	S _____ T _____ R _____	

RECORDED

96 DEC 20 PM 12: 20

Richard R. Chubb
REGISTER OF DEEDS
OTTAWA COUNTY, MI

Register of Deeds Stamp & File Number

4. Lot No. _____, Recorded Plat _____
5. Private Claims _____

	A	B	C	D	E	F	G	H	I	J	K	L	M
1													
2	6	5	4	3	2	1							
3													
4	7	8	9	10	11	12							
5													
6	18	17	16	15	14	13							
7													
8	19	20	21	22	23	24							
9													
10	30	29	28	27	26	25							
11													
12	31	32	33	34	35	36							

I, Steven Lampen, in a field survey on December 5 1996, do hereby certify that under requirements of P.A. 74, Michigan P.A. of 1970, the corner points mentioned in lines 1 and 2 above were in conformance with regulations and rules therefore as required in the current manual of survey instructions of the United States Department of the Interior, Bureau of Land Management or by a decree of a Court of Law and/or that the corner points mentioned in lines 3, 4 and 5 above were in conformance with the rules of the Michigan Board of Land Surveyors or by a Decree of a Court of Law; established, re-established, monumented, re-monumented, recovered, found as expressed below:

NOTE: Not more than 4 corners, all in the same town and range, may be recorded on this certificate.

A. Description of original monument and accessories and/or subsequent restoration:

H-11-GLO-Brookfield-1832
East on Ran. Bet. Sec. 27 and 34
17.50 to lake
40.00 temp 1/2 Sec. post in lake
80.09 East line in lake
West-corrected west
40.04 1/4 sec. post in lake
62.59 left lake and set post
80.09 section corner

Section line between Section 27 and 34 is shown on Plat of Chippewa Resort-1914 Plat of Bay View-1924, and on Heneveld's Supervisor's Plat No.22-1935

**P.A. 345 OTTAWA COUNTY
PEER APPROVED 12-9-96**

S. D. N.

B. Description of corner evidence found and/or method applied in restoring or reestablishing corner:


H-11 Found no field evidence or survey record that H-11 had ever been located since the original GLO survey. Calculated position of H-11 and the section line between Section 27 and 34 by using the plats listed in Part A for the North and South location and proportioned the GLO measurement for the East and West locations. See sketch on back. Set Ottawa County Remonumentation Iron and Cap as a reference monument on the section line between Sections 27 and 34.

Calculated position of H-11 and the section line between Sections 27 and 34 are accepted as a careful and faithful re-establishment of the position of the original corner and section line.

C. Description of monument for corner and accessories established to perpetuate locating the position of the corner:

Reference monument
H-11 See sketch on back - Azimuths=Michigan State Plane Grid Direction
Ottawa County Remonumentation Iron and Cap on section line between Sections 27 and 34.

SE corner house, brick	234°41'	155.97
SE corner house, brick	329°01'	85.39
NE corner garage, brick	343°12'	156.08
SW corner steel seawall, cap	74°27'	11.12
N'y shore Lake Macatawa	91°34'	12
N'y shore Lake Macatawa	180°	8
G-11=remon. iron in mon. box	271°34'29"	1080.0
GLO meander post position	91°34'29"	79.54

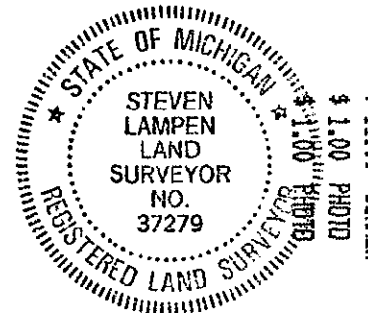

Signed by Steven Lampen Date DECEMBER 13, 1996
Surveyor's Michigan License No. 37279

FORM APPROVED BY MICHIGAN STATE BOARD OF LAND SURVEYORS, JAN. 28, 1971
REVISED MAY 14, 1975
REVISED JAN., 1983
ADAPTED FOR WORD PROCESSING MARCH, 1983

