

**Ottawa County Remonumentation  
LAND CORNER RECORDATION CERTIFICATE**  
Filing Requirement of Act 74, Mich. P.A. 1970

RECORDED

97 JUL 24 PM 2: 24

*D. J. ...*  
REGISTER OF DEEDS  
OTTAWA COUNTY, MI

|   |             |               |
|---|-------------|---------------|
| For corners in<br><u>Ottawa</u><br>(County) | Located In: | Corner Code # |
| 1. Public Land Survey                       | T 5N R 16W  | I-1           |
|   | T R         | Park Twp.     |
|   | T R         | NE CORNER     |
|   | T R         | SECTION 3     |
| 2. Property Controlling<br>in Section       | S T R       |               |
|   | S T R       |               |
| 3. Miscellaneous<br>Property in Sec.        | S T R       |               |
|   | S T R       |               |

Register of Deeds Stamp & File Number

4. Lot No. \_\_\_\_\_, Recorded Plat \_\_\_\_\_  
5. Private Claims \_\_\_\_\_

I, Steven Lampen, in a field survey on Nov. 8 19 96, do hereby certify that under requirements of P.A. 74, Michigan P.A. of 1970, the corner points mentioned in lines 1 and 2 above were in conformance with regulations and rules therefore as required in the current manual of survey instructions of the United States Department of the Interior, Bureau of Land Management or by a decree of a Court of Law and/or that the corner points mentioned in lines 3, 4 and 5 above were in conformance with the rules of the Michigan Board of Land Surveyors or by a Decree of a Court of Law; established, re-established, monumented, re-monumented, recovered, found as expressed below:

|    |   |    |    |    |    |    |    |   |   |   |   |   |   |
|----|---|----|----|----|----|----|----|---|---|---|---|---|---|
| 1  | A | B  | C  | D  | E  | F  | G  | H | I | J | K | L | M |
| 2  |   | 6  | 5  | 4  | 3  | 2  | 1  |   |   |   |   |   |   |
| 3  |   |    |    |    |    |    |    |   |   |   |   |   |   |
| 4  |   | 7  | 8  | 9  | 10 | 11 | 12 |   |   |   |   |   |   |
| 5  |   |    |    |    |    |    |    |   |   |   |   |   |   |
| 6  |   | 18 | 17 | 16 | 15 | 14 | 13 |   |   |   |   |   |   |
| 7  |   |    |    |    |    |    |    |   |   |   |   |   |   |
| 8  |   | 19 | 20 | 21 | 22 | 23 | 24 |   |   |   |   |   |   |
| 9  |   |    |    |    |    |    |    |   |   |   |   |   |   |
| 10 |   | 30 | 29 | 28 | 27 | 26 | 25 |   |   |   |   |   |   |
| 11 |   |    |    |    |    |    |    |   |   |   |   |   |   |
| 12 |   | 31 | 32 | 33 | 34 | 35 | 36 |   |   |   |   |   |   |
| 13 |   |    |    |    |    |    |    |   |   |   |   |   |   |

**NOTE: Not more than 4 corners, all in the same town and range, may be recorded on this certificate.**

**A. Description of original monument and accessories and/or subsequent restoration:**

|                                |                                   |
|--------------------------------|-----------------------------------|
| I-1                            | LCRC L5 P100 1983                 |
| GLO-Brookfield 1832            | Found angle iron in monument box, |
| North boundary 40 West of post | set cast iron monument            |
| and set cor                    | Port Sheldon Twp. cor E 26.54     |
| Pine 36 S40E 30                | P.P. SE 40.64                     |
| Pine 10 S66W 10                | 14" Pine NE 60.16                 |
|                                | TP WSW 58.49                      |

**B. Description of corner evidence found and/or method applied in restoring or reestablishing corner:**

I-1  
Found cast iron monument in monument box  
Port Sheldon Twp. cor E 26.54  
P.P. SE 40.64  
TP WSW 58.49


Established corner at intersection of East line Section 3 with South line of Section 34, T6N, R16W and accepted it as a careful and faithful perpetuation of the position of the original corner.

P.A. 345 OTTAWA COUNTY  
PEER APPROVED 12-9-96  
*S.D.T.*

**C. Description of monument for corner and accessories established to perpetuate locating the position of the corner:**

I-1  
Established corner at intersection of East line Section 3 with the South line of Section 34, T6N, R16W. Az.=Mich. State Plane Grid direction.

|  |         |        |
|--|---------|--------|
| Centerline east and west asphalt road pavement | N       | 0      |
| Cast iron monument in mon box                  | 2°14'   | 0.06   |
| I-13, T6N, R16W=CIM in mon box                 | 90°10'  | 26.51  |
| SW cor brick bldg.                             | 143°22' | 116.42 |
| Remon tag W. side 14" oak                      | 14°29'  | 71.32  |
| Remon tag E. side 10" quad maple               | 206°01' | 95.58  |
| Remon tag N. side 12" twin oak                 | 353°56' | 114.02 |

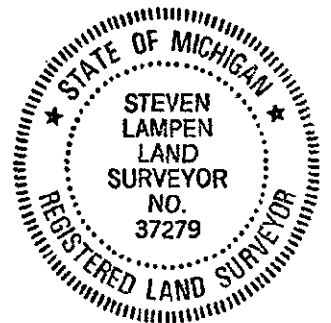

Signed by Steven Lampen Date November 11, 1996

Surveyor's Michigan License No. 37279

FORM APPROVED BY MICHIGAN STATE BOARD OF LAND SURVEYORS, JAN. 23, 1971  
REVISED MAY 14, 1976  
REVISED JAN., 1993  
ADAPTED FOR WORD PROCESSING MARCH, 1993