

**SURVEY & REMONUMENTATION**

APR 05 1996

**OTTAWA COUNTY REMONUMENTATION LAND CORNER RECORDATION CERTIFICATE**

Filing Requirement of Act 74, Mich. P.A. 1970

**COMMISSION**

For corners in  
Ottawa \_\_\_\_\_  
(County)

Located in:

Corner Code #

|                                    |         |         |                 |
|------------------------------------|---------|---------|-----------------|
| 1. Public Land Survey              | T5N     | R16W    | I-2             |
|                                    | T _____ | R _____ | E 1/4 cor. Sec. |
|                                    | T _____ | R _____ | 3, Park Twp.    |
|                                    | T _____ | R _____ | _____           |
| 2. Property Controlling in Section | S _____ | T _____ | R _____         |
|                                    | S _____ | T _____ | R _____         |
| 3. Miscellaneous Property in Sec.  | S _____ | T _____ | R _____         |
|                                    | S _____ | T _____ | R _____         |

**RECORDED**

95 NOV 15 PM 2:08

*Polycia Kullman*  
REGISTER OF DEEDS  
OTTAWA COUNTY, MI

Register of Deeds Stamp & File Number

4. Lot No. \_\_\_\_\_, Recorded Plat \_\_\_\_\_  
5. Private Claims \_\_\_\_\_

| A  | B  | C  | D  | E  | F  | G  | H | I | J | K | L | M |
|----|----|----|----|----|----|----|---|---|---|---|---|---|
| 1  |    |    |    |    |    |    |   |   |   |   |   |   |
| 2  | 6  | 5  | 4  | 3  | 2  | 1  |   |   |   |   |   |   |
| 3  |    |    |    |    |    |    |   |   |   |   |   |   |
| 4  | 7  | 8  | 9  | 10 | 11 | 12 |   |   |   |   |   |   |
| 5  |    |    |    |    |    |    |   |   |   |   |   |   |
| 6  | 18 | 17 | 16 | 15 | 14 | 13 |   |   |   |   |   |   |
| 7  |    |    |    |    |    |    |   |   |   |   |   |   |
| 8  | 19 | 20 | 21 | 22 | 23 | 24 |   |   |   |   |   |   |
| 9  |    |    |    |    |    |    |   |   |   |   |   |   |
| 10 | 30 | 29 | 28 | 27 | 26 | 25 |   |   |   |   |   |   |
| 11 |    |    |    |    |    |    |   |   |   |   |   |   |
| 12 | 31 | 32 | 33 | 34 | 35 | 36 |   |   |   |   |   |   |
| 13 |    |    |    |    |    |    |   |   |   |   |   |   |

I, Steven Lampen \_\_\_\_\_, in a field survey on October 12, 1995, do hereby certify that under requirements of P.A. 74, Michigan P.A. of 1970, the corner points mentioned in lines 1 and 2 above were in conformance with regulations and rules therefore as required in the current manual of survey instructions of the United States Department of the Interior, Bureau of Land Management or by a decree of a Court of Law and/or that the corner points mentioned in lines 3, 4 and 5 above were in conformance with the rules of the Michigan Board of Land Surveyors or by a Decree of a Court of Law; established, re-established, monumented, re-monumented, recovered, found as expressed below:

**NOTE: Not more than 4 corners, all in the same town and range, may be recorded on this certificate.**

**A. Description of original monument and accessories and/or subsequent restoration:**

|                                                                      |   |   |   |
|----------------------------------------------------------------------|---|---|---|
| GLO-<br>April, 1832<br>Calvin Britain<br>Set Post<br>Pine 10 is Post | LCRC L 1-P 63<br>Power pole SE 38.04'<br>18" Maple NW 64.27'<br>44" Oak ENE 108.08'<br>8" Cherry SW 54.67'<br>Guy Pole NE 38.06' | LCRC L 5-P 309<br>Cast Iron Monument<br>Power pole nail W. side SE 38.88'<br>12" Oak Tag #14091 NE 89.35'<br>NE Corner Garage Fndn SW 158.30'<br>12" Maple NW 67.30' | LCRC L 6-P 14<br>Set CIM<br>Power pole SE 38.73'<br>12" Box Elder Tree SSW 63.97'<br>14" Maple Tree NNW 67.49'<br>16" Oak Tree NE 83.88' |
|----------------------------------------------------------------------|---|---|---|

**B. Description of corner evidence found and/or method applied in restoring or reestablishing corner:**

Found C.I.M. in Mon. Box and is accepted as a careful and faithful perpetuation of the position of the original corner.


|                      |                                   |                               |
|----------------------|-----------------------------------|-------------------------------|
| Power pole SE 38.04' | Power pole nail W. side SE 38.88' | Power pole SE 38.73'          |
| 18" Maple NW 64.27'  | 12" Oak Tag #14091 NE 89.35'      | 12" Box Elder Tree SSW 63.97' |
| 44" Oak ENE 108.08'  | NE cor. Garage Fndn SW 158.30'    | 14" Maple Tree NNW 67.49'     |
|                      | 12" Maple NW 67.30'               | 16" Oak Tree NE 83.88'        |

P.A. 345 OTTAWA COUNTY  
PEER APPROVED 10/23/95

*Robert D. McDowell*  
YDM

**C. Description of monument for corner and accessories established to perpetuate locating the position of the corner:**

|                              |          |                  |           |
|------------------------------|----------|------------------|-----------|
| I-2<br>C.I.M. in Mon. Box    | Az=MI    | State Plane Grid | Direction |
| Remon Tag NE side 18" Oak    | 112° 53' | 85.98'           |           |
| Remon Tag NE side Power pole | 134° 24' | 38.57'           |           |
| Centerline, top hydrant      | 60° 27'  | 58.39'           |           |
| Remon Tag SE side 12" Oak    | 47° 14'  | 67.96'           |           |
| Tag #14091 NW side 12" Oak   | 36° 15'  | 89.31'           |           |
| Remon Tag NE side 20" Oak    | 302° 06' | 65.07'           |           |
| Remon Tag NE side 16" Oak    | 337° 25' | 67.42'           |           |
| Remon Tag NW side Power pole | 252° 46' | 81.94'           |           |

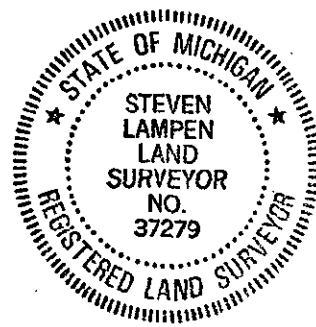

Signed by Steven Lampen

Date October 23, 1995

Surveyor's Michigan License No. 37279

FORM APPROVED BY MICHIGAN STATE BOARD OF LAND SURVEYORS, JAN.