

RECORDED

93 NOV -8 PM 1:53

OTTAWA COUNTY REMONUMENTATION

LAND CORNER RECORDATION CERTIFICATE
Filing Requirement of Act 74, Mich. P.A. 1970

Phyllis Robinson
REGISTER OF DEEDS
OTTAWA COUNTY, MI

For corners in
Ottawa

COMMISSION

	Located In:	Corner Code #
1. Public Land Survey	T <u>5N</u> R <u>16W</u>	<u>1-3 (NE Sec 10)</u>
	T _____ R _____	<u>Park Twp.</u>
	T _____ R _____	_____
	T _____ R _____	_____
2. Property Controlling in Section	S _____ T _____ R _____	_____
	S _____ T _____ R _____	_____
3. Miscellaneous Property in Sec.	S _____ T _____ R _____	_____
	S _____ T _____ R _____	_____

Register of Deeds Stamp & File Number

- 4. Lot No. _____, Recorded Plat _____
- 5. Private Claims _____

A	B	C	D	E	F	G	H	I	J	K	L	M
2	6	5	4	3	2	1						
3												
4	7	8	9	10	11	12						
5												
6	18	17	16	15	14	13						
7												
8	19	20	21	22	23	24						
9												
10	30	29	28	27	26	25						
11												
12	31	32	33	34	35	36						
13												

I, David R. Greer, in a field survey on September 15, 19 93, do hereby certify that under requirements of P.A. 74, Michigan P.A. of 1970, the corner points mentioned in lines 1 and 2 above were in conformance with regulations and rules therefore as required in the current manual of survey Instructions of the United States Department of the Interior, Bureau of Land Management or by a decree of a Court of Law and/or that the corner points mentioned in lines 3, 4 and 5 above were in conformance with the rules of the Michigan Board of Land Surveyors or by a Decree of a Court of Law; established, re-established, monumented, re-monumented, recovered, found as expressed below:

NOTE: Not more than 4 corners, all in the same town and range, may be recorded on this certificate.

A. Description of original monument and accessories and/or subsequent restoration:

Recorded in Liber 3 Page 352, June 28, 1979
1-3

Found Cast Iron Monument
24" Oak SE 46.75'
8" Ash SW 66.42'
12" Maple NE 32.24'

Recorded in Liber 1 Page 63, Sept 22, 1971
1-3

Nail in face of 24" Oak SE 46.75'
Nail in face of 8" Ash SW 66.42'
Nail in face of 12" Maple NE 32.24'
Nail in face of 20" Maple NW 56.18'
CL Street Sign SE 34.31'

B. Description of corner evidence found and/or method applied in restoring or reestablishing corner:

1-3

Found cast iron monument and accepted it as a careful and faithful perpetuation of the position of the original corner
24" Oak SE 46.75'
Nail in face of 8" Ash SW 66.42'
Nail in face of 12" Maple NE 32.24'
Nail in face of 20" Maple NW 56.18'
CL Street Sign SE 34.31'


C. Description of monument for corner and accessories established to perpetuate locating the position of the corner:

1-3

Found C.I.M. in monument box

AZ - Michigan State Grid Direction

O.C. Remon tag & nail in SW Side 24" Oak AZ. 319°08' 117.66'
O.C. Remon tag & nail in NW Side 24" Maple AZ. 230°24' 97.06'
SW Cor House Concrete Block AZ. 34°17' 95.42'
SW Cor House Wood Siding AZ. 149°44' 119.50'

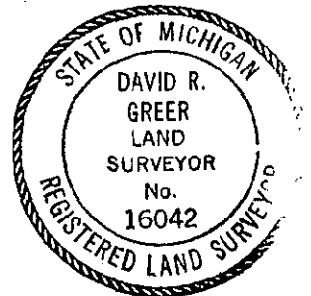

Signed by David R. Greer

Date 9/15/93

Surveyor's Michigan License No. 16042