

RECORDED
 1993
 COMMISSION

OTTAWA COUNTY REMONUMENTATION

RECORDED
 93 NOV -8 PM 1:53

LAND CORNER RECORDATION CERTIFICATE
 Filing Requirement of Act 74, Mich. P.A. 1970

Deborah Ballman
 REGISTER OF DEEDS
 OTTAWA COUNTY, MI

For corners in
Ottawa

(County)

Located In:


Corner Code #

1. Public Land Survey	T	5N	R	16W	1-7 (NE Sec. 22)
	T		R		Park Twp.
	T		R		
	T		R		
2. Property Controlling in Section	S		T	R	
	S		T	R	
3. Miscellaneous Property in Sec.	S		T	R	
	S		T	R	

Register of Deeds Stamp & File Number

4. Lot No. _____, Recorded Plat _____
 5. Private Claims _____

I, David R. Greer, in a field survey on September 15, 19 93, do hereby certify that under requirements of P.A. 74, Michigan P.A. of 1970, the corner points mentioned in lines 1 and 2 above were in conformance with regulations and rules therefore as required in the current manual of survey instructions of the United States Department of the Interior, Bureau of Land Management or by a decree of a Court of Law and/or that the corner points mentioned in lines 3, 4 and 5 above were in conformance with the rules of the Michigan Board of Land Surveyors or by a Decree of a Court of Law; established, re-established, monumented, re-monumented, recovered, found as expressed below:

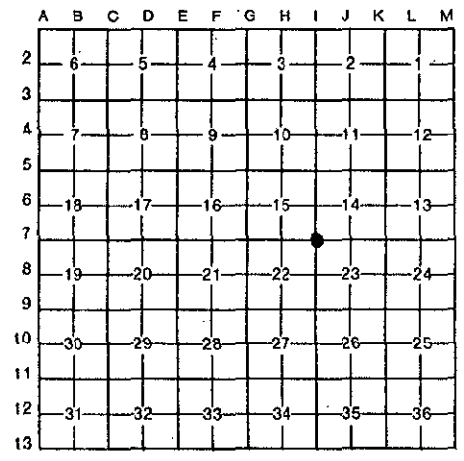

NOTE: Not more than 4 corners, all in the same town and range, may be recorded on this certificate.

A. Description of original monument and accessories and/or subsequent restoration:

Recorded in Liber 1 Page 803 Dec. 8, 1972 1-7 Found Mon. Box	Recorded in Liber 5 Page 143 June 27, 1984 1-7 Cast Iron Monument	Recorded in Liber 6 Page 173 October 11, 1991 1-7 Reset CIM from previous ties
Power Pole NE 63.40'	10" Poplar SW 70.21'	10" Poplar SW 77.34'
Power Pole SE 57.93'	LP SE 34.26'	Light Pole SE 34.28'
CL Street Sign SE 36.77'	Power Pole ESE 58.10'	Power Pole ESE 58.10'
	Power Pole NE 63.82'	Power Pole NE 63.82'

B. Description of corner evidence found and/or method applied in restoring or reestablishing corner:

1-7
 Found Cast Iron Monument and accepted it as a careful and faithful perpetuation of the position of the original corner
 10" Poplar SW 77.34' (N Side)
 Light Pole SE 34.28' (W Side)
 Power Pole ESE 58.10' (N Side)
 Power Pole NE 63.82' (NW Side)

C. Description of monument for corner and accessories established to perpetuate locating the position of the corner:

1-7
 Found C.I.M. in Monument Box. Set O.C. Remonumentation Iron & Cap
 AZ - Michigan State Plane Grid Direction
 O.C. Remon tag & nail in NW Side Power Pole AZ. 52°20' 63.29'
 O.C. Remon tag & nail in SW Side Power Pole AZ. 118°36' 58.27'
 O.C. Remon tag & nail in SE Side 8" Poplar AZ. 218°44' 76.69'
 Found Nail & Cap #14091 in NW Side 10" Poplar AZ. 245°35' 77.31'

Signed by David R. Greer
 Surveyor's Michigan License No. 16042

Date 9/15/93

