

OUT
RANGE

1993

OTTAWA COUNTY REMONUMENTATION

RECORDED

93 NOV -8 PM 1:53

LAND CORNER RECORDATION CERTIFICATE
Filing Requirement of Act 74, Mich. P.A. 1970

Elizabeth Schmitt
REGISTER OF DEEDS
OTTAWA COUNTY, MI

For corners in
Ottawa

COMMISSION

Located In:

Corner Code =#


1. Public Land Survey	T	5N	R	16W	1-9 (SW Sec 23)
	T		R		Park Twp.
	T		R		
	T		R		
2. Property Controlling in Section	S		T	R	
	S		T	R	
3. Miscellaneous Property in Sec.	S		T	R	
	S		T	R	

Register of Deeds Stamp & File Number

- 4. Lot No. _____, Recorded Plat _____
- 5. Private Claims _____

I, David R. Greer, in a field survey on September 15, 19 93, do hereby certify that under requirements of P.A. 74, Michigan P.A. of 1970, the corner points mentioned in lines 1 and 2 above were in conformance with regulations and rules therefore as required in the current manual of survey instructions of the United States Department of the Interior, Bureau of Land Management or by a decree of a Court of Law and/or that the corner points mentioned in lines 3, 4 and 5 above were in conformance with the rules of the Michigan Board of Land Surveyors or by a Decree of a Court of Law; established, re-established, monumented, re-monumented, recovered, found as expressed below:

NOTE: Not more than 4 corners, all in the same town and range, may be recorded on this certificate.

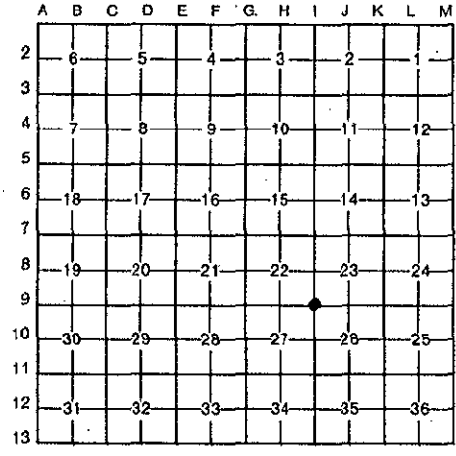

A. Description of original monument and accessories and/or subsequent restoration:

Recorded in Liber 2 Page 273, Aug. 7, 1973 I-9 Found Iron Pipe	Recorded in Liber 2, Page 733, Jan 14, 1975 I-9 Found Iron Pipe	Recorded in Liber 4, Page 216 Sept. 23, 1981 I-9 Set Cast Iron Monument
Power Pole SW 50.25'	NW Cor Fence SE 60.22'	Guy Pole NW 50.63'
18" Maple SW 37.05'	Tele. Pole SW 50.12'	Power Pole SE 57.17'
20" Ash NW 89.36'	30" Ash NW 68.60'	Power Pole SW 50.66'
Power Pole SE 58.60'	14" Ash NE 61.66'	21" Ash NE 62.90'
Tele Pole NW 50.73'		
20" Cherry NE 75.60'		

B. Description of corner evidence found and/or method applied in restoring or reestablishing corner:
I-9

Found cast iron monument and accepted it as a careful and faithful perpetuation of the position of the original corner

Guy Pole	NW	50.63'
Power Pole	SE	57.17'
Power Pole	SW	50.66'
21" Ash	NE	62.90'


C. Description of monument for corner and accessories established to perpetuate locating the position of the corner:
I-9

Found C.I.M. in monument box
AZ - Michigan State Grid Direction

NW Cor Building Concrete Block Foundation	AZ. 134°55'	102.77'
SE Cor House Foundation	AZ. 218°55'	140.57'
SW Cor House Foundation	AZ. 307°16'	150.27'
NW Cor House Foundation	AZ. 37°53'	118.37'

Signed by David R. Greer
Surveyor's Michigan License No. 16042

Date 9/15/93

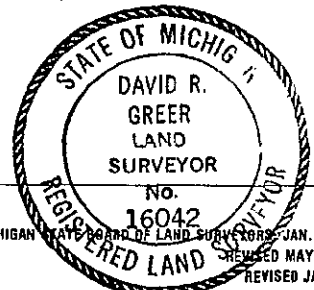

FORM APPROVED BY MICHIGAN STATE BOARD OF LAND SURVEYORS JAN. 28, 1971
REVISED MAY 14, 1975
REVISED JAN., 1983