

**OTTAWA COUNTY REMONUMENTATION
LAND CORNER RECORDATION CERTIFICATE**
Filing Requirement of Act 74, Mich. P.A. 1970

RECORDED
97 JUL 24 PM 2: 25

Phyllis Coleman
REGISTER OF DEEDS
OTTAWA COUNTY, MI

For corners in Ottawa _____ (County)	Located In:	Corner Code #
1. Public Land Survey	T5N R16W	J-1 _____
	T _____ R _____	N 1/4 cor. Sec. 2
	T _____ R _____	Park Twp.
	T _____ R _____	_____
2. Property Controlling in Section	S _____ T _____ R _____	_____
	S _____ T _____ R _____	_____
3. Miscellaneous Property in Sec.	S _____ T _____ R _____	_____
	S _____ T _____ R _____	_____

Register of Deeds Stamp & File Number

4. Lot No. _____, Recorded Plat _____
5. Private Claims _____

I, Steven Lampen _____, in a field survey on December 6, 1996, do hereby certify that under requirements of P.A. 74, Michigan P.A. of 1970, the corner points mentioned in lines 1 and 2 above were in conformance with regulations and rules therefore as required in the current manual of survey instructions of the United States Department of the Interior, Bureau of Land Management or by a decree of a Court of Law and/or that the corner points mentioned in lines 3, 4 and 5 above were in conformance with the rules of the Michigan Board of Land Surveyors or by a Decree of a Court of Law; established, re-established, monumented, re-monumented, recovered, found as expressed below:

1	A	B	C	D	E	F	G	H	I	J	K	L	M
2	6	5	4	3	2	1							
3													
4	7	8	9	10	11	12							
5													
6	18	17	16	15	14	13							
7													
8	19	20	21	22	23	24							
9													
10	30	29	28	27	26	25							
11													
12	31	32	33	34	35	36							
13													

NOTE: Not more than 4 corners, all in the same town and range, may be recorded on this certificate.

A. Description of original monument and accessories and/or subsequent restoration:

J-1
GLO - corner not set by original GLO Survey

J-1 is not recorded

Survey recorded in Liber 2 Page 968 - 1976
Shows angle iron at J-1,
J-1 to J-2 = 2805.75'
J-1 to K-1 = 2659.47'

B. Description of corner evidence found and/or method applied in restoring or reestablishing corner:

J-1 Found angle iron in monument box on South line of Section 35, Town 6 North, Range 16 West
J-1 to J-2 rec. = 2805.75' meas. = 2805.89'
J-1 to K-1 rec. = 2659.46' meas. = 2659.46'


This corner not monumented by the original GLO Survey. This monument is accepted as the best available evidence of the position of the corner. Replaced angle iron with an Ottawa County Remonumentation iron and cap.

P.A. 345 OTTAWA COUNTY
PEER APPROVED 12-9-96

S.D.N.

C. Description of monument for corner and accessories established to perpetuate locating the position of the corner:
J-1 Ottawa County Remonumentation iron and cap in monument box on South line of Section 35, Town 6 North, Range 16 West. Azimuth = Michigan State Plane grid direction.

J-13 T6N, R16W = C.I.M. in Monument box	90°	28'	10.16'
Remon. tag in SE side 10" Oak	52°	14'	61.28'
NW corner house foundation	156°	33'	111.56'
NE corner house foundation	132°	49'	151.67'
Remon. tag in SW side power pole	301°	44'	105.66'
Centerline E and W asphalt road pavement	0°		1.'
Mid-point I-1 to K-1	90°	28'	0.28'

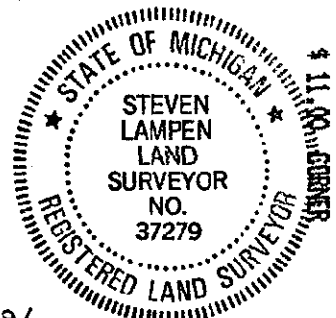

Signed by Steven Lampen Date DECEMBER 13, 1996

Surveyor's Michigan License No. 37279

