

**Ottawa County Remonumentation
LAND CORNER RECORDATION CERTIFICATE
Filing Requirement of Act 74, Mich. P.A. 1970**

RECORDED

97 JUL 24 PM 2: 23

Polina Redman
**REGISTER OF DEEDS
OTTAWA COUNTY, MI**

For corners in		Located In:	Corner Code #
<u>Ottawa</u>			
(County)			
1. Public Land Survey	T 5N R 16W	K-1	
	T R	Park Twp.	
	T R	NW CORNER	
	T R	SECTION 1	
2. Property Controlling in Section	S T R		
	S T R		
3. Miscellaneous Property in Sec.	S T R		
	S T R		

Register of Deeds Stamp & File Number

4. Lot No. _____, Recorded Plat _____
5. Private Claims _____

I, Steven Lampen, in a field survey on Nov. 8 19 96, do hereby certify that under requirements of P.A. 74, Michigan P.A. of 1970, the corner points mentioned in lines 1 and 2 above were in conformance with regulations and rules therefore as required in the current manual of survey instructions of the United States Department of the Interior, Bureau of Land Management or by a decree of a Court of Law and/or that the corner points mentioned in lines 3, 4 and 5 above were in conformance with the rules of the Michigan Board of Land Surveyors or by a Decree of a Court of Law; established, re-established, monumented, re-monumented, recovered, found as expressed below:

NOTE: Not more than 4 corners, all in the same town and range, may be recorded on this certificate.

	A	B	C	D	E	F	G	H	I	J	K	L	M
1													
2	6	5	4	3	2	1							
3													
4	7	8	9	10	11	12							
5													
6	18	17	16	15	14	13							
7													
8	19	20	21	22	23	24							
9													
10	30	29	28	27	26	25							
11													
12	31	32	33	34	35	36							
13													

A. Description of original monument and accessories and/or subsequent restoration:

K-1 GLO Brookfield 1832 North boundary 10 East of post and set cor Hemlock 10 S 3E 10 Hemlock 9 S61W 52	L1 P77-1971 Found steel bar, stone, axe head and crockery, set cast iron monument PP NE 37.54 Centerline hydrant SE 29.74 Centerline st. sign SE 36.27 Centerline pipeline breather NE 75.92 Post Sheldon is West 6.60
--	---

B. Description of corner evidence found and/or method applied in restoring or reestablishing corner:

K-1
Found cast iron monument in monument box
Centerline pipeline breather NE 75.92
Post Sheldon is West 6.60


Established corner at intersection of West line Section 1 with the South line of Section 36, T6N, R16W and accepted it as a careful and faithful perpetuation of the position of the original corner.

P.A. 345 OTTAWA COUNTY
PEER APPROVED 12-9-96
[Signature]

C. Description of monument for corner and accessories established to perpetuate locating the position of the corner:

K-1
Established corner at intersection of West line Section 1 with the South line of Section 36, T6N, R16W. Az.= Mich. State Plane Grid direction

Centerline east and west asphalt road pavement	N	0
Cast iron monument in monument box	0°32'	0.08
K-13 T6N R16W=C.I.M. in mon box	270°29'	6.39
Centerline hydrant	140°43'	32.75
Remon tag in NW side power pole	195°34'	158.98
Remon tag in West side power pole	175°24'	152.50

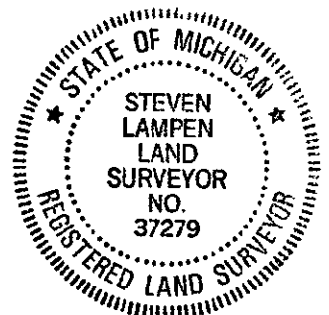

Signed by Steve Lampen Date November 11, 1996

Surveyor's Michigan License No. 37279