

SURVEY & REMONUMENTATION

APR 05 1996

COMMISSION

**OTTAWA COUNTY REMONUMENTATION
LAND CORNER RECORDATION CERTIFICATE
Filing Requirement of Act 74, Mich. P.A. 1970**

For corners in
Ottawa _____ Located In: _____ Corner Code # _____
(County)

1. Public Land Survey T5N R16W K-2
T _____ R _____ E 1/4 cor. Sec.
T _____ R _____ 2, Park Twp.
T _____ R _____

2. Property Controlling S _____ T _____ R _____
in Section S _____ T _____ R _____

3. Miscellaneous S _____ T _____ R _____
Property in Sec. S _____ T _____ R _____

4. Lot No. _____, Recorded Plat _____

5. Private Claims _____

RECORDED
95 NOV 15 PM 2:08
Elizabeth Kullman
REGISTER OF DEEDS
OTTAWA COUNTY, MI
Register of Deeds Stamp & File Number

I, Steven Lampen _____, in a field survey on October 12, 1995, do hereby certify that under requirements of P.A. 74, Michigan P.A. of 1970, the corner points mentioned in lines 1 and 2 above were in conformance with regulations and rules therefore as required in the current manual of survey instructions of the United States Department of the Interior, Bureau of Land Management or by a decree of a Court of Law and/or that the corner points mentioned in lines 3, 4 and 5 above were in conformance with the rules of the Michigan Board of Land Surveyors or by a Decree of a Court of Law; established, re-established, monumented, re-monumented, recovered, found as expressed below:

1	A	B	C	D	E	F	G	H	I	J	K	L	M
2	6	5	4	3	2	1							
3													
4	7	8	9	10	11	12							
5													
6	18	17	16	15	14	13							
7													
8	19	20	21	22	23	24							
9													
10	30	29	28	27	26	25							
11													
12	31	32	33	34	35	36							
13													

NOTE: Not more than 4 corners, all in the same town and range, may be recorded on this certificate.

A. Description of original monument and accessories and/or subsequent restoration:

GLO April, 1832 Surveyor - Calvin Britain Set post 9" Beech North 48°E 8' 12" Beech South 48°W 9'	LCRC L1-P77 1971 Nail in face of power pole NW 83.17' Nail in face of 28" Maple SW 70.14' Nail in face of 22" Maple SW 82.81' centerline street sign SW 39.86' centerline street sign ENE 128.88'	LCRC L6-P14 1989 Set CIM Light pole NE 62.28' Power pole NW 83.79' 26" Maple SSW 83.74' 36" Maple SW 70.58'
--	--	--

B. Description of corner evidence found and/or method applied in restoring or reestablishing corner:

Found CIM in monument box and is accepted as a careful and faithful perpetuation of the position of the original corner.


Power pole NW 83.17'	Light pole NE 62.28'
28" Maple SW 70.14'	Power pole NW 83.79'
22" Maple SW 82.81'	26" Maple SSW 83.74'
	36" Maple SW 70.58'

P.A. 345 OTTAWA COUNTY
PEER APPROVED 10/23/95

Robert D. Redwood
RDR

C. Description of monument for corner and accessories established to perpetuate locating the position of the corner:

K-2 CIM in monument box	AZ = Michigan State plane grid direction
Remon tag NW side power pole	64° 29' 62.43'
Centerline, top of hydrant	142° 53' 47.17'
Remon tag NE side power pole	325° 54' 83.66'
NE corner house foundation	219° 41' 121.30'
NW corner house foundation	230° 16' 150.11'

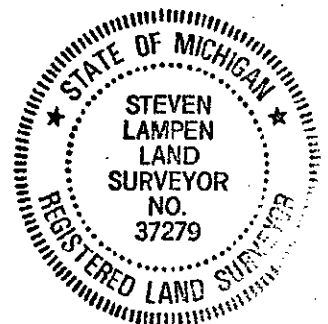

Signed by Steven Lampen Date October 23, 1995
Surveyor's Michigan License No. 37279