

1993

OTTAWA COUNTY REMONUMENTATION

RECORDED

93 NOV -8 PM 1:57

LAND CORNER RECORDATION CERTIFICATE
Filing Requirement of Act 74, Mich. P.A. 1970

REGISTER OF DEEDS
OTTAWA COUNTY, MI

For corners in
Ottawa

Located In:


Corner Code #

Table with 3 columns: Item description, Located In (T, R, S), and Corner Code # (K-9, Park Twp., etc.)

Register of Deeds Stamp & File Number

4. Lot No. , Recorded Plat
5. Private Claims

I, David R. Greer, in a field survey on September 15, 1993, do hereby certify that under requirements of P.A. 74, Michigan P.A. of 1970, the corner points mentioned in lines 1 and 2 above were in conformance with regulations and rules therefore as required in the current manual of survey instructions of the United States Department of the Interior, Bureau of Land Management or by a decree of a Court of Law and/or that the corner points mentioned in lines 3, 4 and 5 above were in conformance with the rules of the Michigan Board of Land Surveyors or by a Decree of a Court of Law; established, re-established, monumented, re-monumented, recovered, found as expressed below:

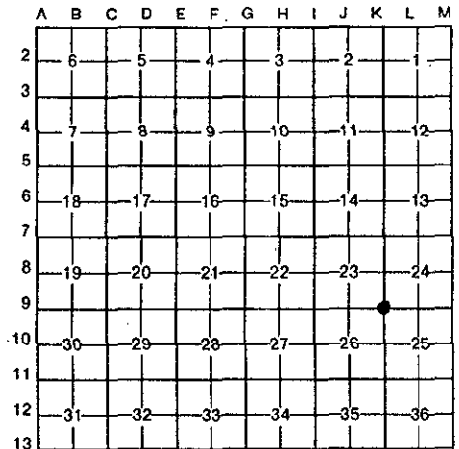

NOTE: Not more than 4 corners, all in the same town and range, may be recorded on this certificate.

A. Description of original monument and accessories and/or subsequent restoration:


Table listing monument details: Recorded in Liber 1 Page 387 (May 11, 1972), Liber 2 Page 109 (April 13, 1973), and Liber 4 Page 326 (June 10, 1982). Includes descriptions like '8" Pine NE 50.98'', '12" Spruce N15°E 161.55'', etc.

B. Description of corner evidence found and/or method applied in restoring or reestablishing corner:

K-9
Found brass plug and accepted it as a careful and faithful perpetuation of the position of the original corner
Nail in the face of 12" Spruce N15°E 161.55'
Nail in the face of 24" Oak S85°E 58.01'
Nail in the face of 18" Oak S45°E 73.92'
Nail in the face of Power Pole S30°W 191.26'
Nail in the face of 10" Oak N30°E 147.15'
Nail in the face of 20" Oak N70°E 87.64'

C. Description of monument for corner and accessories established to perpetuate locating the position of the corner:

K-9
Found Brass Plug in monument box
AZ - Michigan State Grid Direction
Found Nail and Cap No. 16042 SW Side 24" Oak AZ. 141°23' 73.95'
Found Nail and Cap No. 16042 S Side 24" Oak AZ. 99°48' 58.80'
Found Nail and Cap No. 16042 NW Side 30" Oak AZ. 55°30' 88.80'
O.C Remon tag & nail in SE Side 18" Tree AZ. 25°25' 148.03'

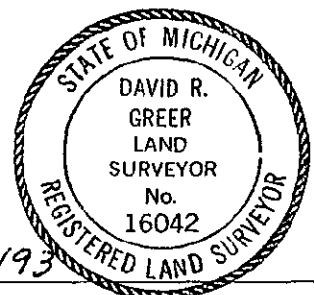

Signed by

David R. Greer

Date

9/15/93

Surveyor's Michigan License No.

16042