

**OTTAWA COUNTY REMONUMENTATION  
LAND CORNER RECORDATION CERTIFICATE**

Filing Requirement of Act 74, Mich. P.A. 1970

For corners in

Ottawa  
(County)

Located in:

Corner Code #

- |                                       |     |      |                 |
|---------------------------------------|-----|------|-----------------|
| 1. Public Land Survey                 | T5N | R16W | K-11            |
|                                       | T   | R    | SE cor. Sec. 26 |
|                                       | T   | R    | Park Twp.       |
|                                       | T   | R    |                 |
| 2. Property Controlling<br>in Section | S   | T    |                 |
|                                       | S   | T    |                 |
| 3. Miscellaneous<br>Property in Sec.  | S   | T    |                 |
|                                       | S   | T    |                 |

**RECORDED**

96 DEC 20 PM 12:19

*Robert J. Robinson*  
REGISTER OF DEEDS  
OTTAWA COUNTY, MI

Register of Deeds Stamp & File Number

4. Lot No. \_\_\_\_\_, Recorded Plat \_\_\_\_\_  
5. Private Claims \_\_\_\_\_

	A	B	C	D	E	F	G	H	I	J	K	L	M
1													
2	6	5	4	3	2	1							
3													
4	7	8	9	10	11	12							
5													
6	18	17	16	15	14	13							
7													
8	19	20	21	22	23	24							
9													
10	30	29	28	27	26	25							
11													
12	31	32	33	34	35	36							
13													

I, Steven Lampen, in a field survey on December 6, 1996, do hereby certify that under requirements of P.A. 74, Michigan P.A. of 1970, the corner points mentioned in lines 1 and 2 above were in conformance with regulations and rules therefore as required in the current manual of survey instructions of the United States Department of the Interior, Bureau of Land Management or by a decree of a Court of Law and/or that the corner points mentioned in lines 3, 4 and 5 above were in conformance with the rules of the Michigan Board of Land Surveyors or by a Decree of a Court of Law; established, re-established, monumented, re-monumented, recovered, found as expressed below:

**NOTE: Not more than 4 corners, all in the same town and range, may be recorded on this certificate.**

A. Description of original monument and accessories and/or subsequent restoration:

K-11  
GLO - Brookfield 1832  
Set corner to Sections 25, 26, 35 and 36  
Pine 10 S 82 E 50'  
Beech 10 W 36'

K-11 is not recorded

K-11 appears on the Plat of Waukazoo - 1901, Plat of First Addition to Waukazoo - 1905, First Subdivision Plat of part of Waukazoo - 1908 and the Plat of Chene du Lac - 1909 the location of the section line between Sections 25 and 26 as dimensioned on the Plat of Waukazoo and First Addition to Waukazoo is not in a reasonable location for either K-11 or K-10 and was not used. K-11 is not dimensioned in a North and South location by the plats.

B. Description of corner evidence found and/or method applied in restoring or reestablishing corner:

K-11  
Found no field evidence or survey record that K-11 had ever been located since the original GLO Survey.  
Re-established K-11 by double proportionate measurement using corners K-10, K-12, G-11 and M-11.

Set Ottawa County Remonumentation iron and cap and is accepted as a careful and faithful re-establishment of the position of the original corner.


**PA. 345 OTTAWA COUNTY  
PEER APPROVED 12-9-96**

*S. D. N.*

C. Description of monument for corner and accessories established to perpetuate locating the position of the corner:

K-11  
Ottawa County Remonumentation iron and cap. Azimuths = Michigan State Plan grid direction

Westerly face concrete wall	98°	0.59'
SE corner house foundation	304° 48'	117.75'
Remon. tag N side 22" Oak	65° 29'	32.20'
NW corner building foundation	147° 15'	165.15'
Remon. tag E side 20" Oak	196° 17'	30.42'

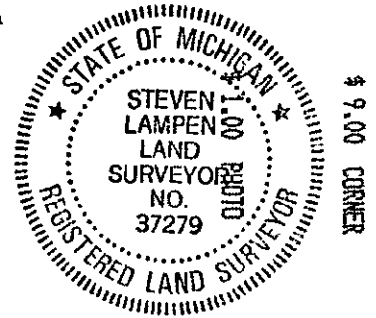

Signed by Steven Lampen

Date DECEMBER 13, 1996

Surveyor's Michigan License No. 37279