

**OTTAWA COUNTY REMONUMENTATION  
LAND CORNER RECORDATION CERTIFICATE**  
Filing Requirement of Act 74, Mich. P.A. 1970

RECORDED

97 JUL 24 PM 2: 25

*R. J. ...*  
REGISTER OF DEEDS  
OTTAWA COUNTY, MI

For corners in Ottawa _____ (County)	Located In:	Corner Code #
1. Public Land Survey	T5N R16W	L-1
	T _____ R _____	N 1/4 cor., Sec. 1,
	T _____ R _____	Park Twp.
	T _____ R _____	_____
2. Property Controlling in Section	S _____ T _____ R _____	_____
	S _____ T _____ R _____	_____
3. Miscellaneous Property in Sec.	S _____ T _____ R _____	_____
	S _____ T _____ R _____	_____

Register of Deeds Stamp & File Number

4. Lot No. \_\_\_\_\_, Recorded Plat \_\_\_\_\_  
5. Private Claims \_\_\_\_\_

I, Steven Lampen \_\_\_\_\_, in a field survey on December 6, 1996 \_\_\_\_\_, do hereby certify that under requirements of P.A. 74, Michigan P.A. of 1970, the corner points mentioned in lines 1 and 2 above were in conformance with regulations and rules therefore as required in the current manual of survey instructions of the United States Department of the Interior, Bureau of Land Management or by a decree of a Court of Law and/or that the corner points mentioned in lines 3, 4 and 5 above were in conformance with the rules of the Michigan Board of Land Surveyors or by a Decree of a Court of Law; established, re-established, monumented, re-monumented, recovered, found as expressed below:

1	A	B	C	D	E	F	G	H	I	J	K	L	M
2		6		5		4		3		2		1	
3													
4		7		8		9		10		11		12	
5													
6		18		17		16		15		14		13	
7													
8		19		20		21		22		23		24	
9													
10		30		29		28		27		26		25	
11													
12		31		32		33		34		35		36	
13													

**NOTE: Not more than 4 corners, all in the same town and range, may be recorded on this certificate.**

A. Description of original monument and accessories and/or subsequent restoration:  
L-1  
GLO - corner not set by original GLO Survey  
LCRC Remon. Liber 2, Page 545 - 1995  
For L-13, T6N, R16W  
L-1, T5N, R16W 90° 34' 3.3'

LCRC Liber 2, Page 9 - 1972  
Found iron pipe on bridge  
SE corner abut. SW 14.95'  
SW corner abut. SE 10.15'  
NW corner abut. NE 10.40'  
NE corner abut. NW 15.05'  
3.3' W to Port Sheldon corner  
L-1 to K-1 = 2643.75'  
L-1 to M-1 = 2641.82'

B. Description of corner evidence found and/or method applied in restoring or reestablishing corner:  
L-1  
Found PK nail in washer on bridge on the south line of Section 36, T6N, R16W  
L-1 to K-1 rec. = 2643.75' meas. = 2644.07'  
L-1 to M-1 rec. = 2641.82' meas. = 2642.01'  
L-13, T6N, R16W 270° 34' 3.30'


This corner not monumented by the original GLO Survey. This monument is accepted as the best available evidence of the position of the corner. Replaced PK nail with an Ottawa County Remonumentation iron and cap in a (set) monument box.

P.A. 345 OTTAWA COUNTY  
PEER APPROVED 12-9-96

*S.D.N.*

C. Description of monument for corner and accessories established to perpetuate locating the position of the corner:  
L-1  
Ottawa County Remonumentation iron and cap in monument box on bridge on the South line of Section 36, T6N, R16W. Azimuth = Michigan State Plane grid direction.

L-13, T6N, R16W = Remon. iron in monument box	270° 34' 29"	3.30'
Remon. tag in W side 12" Pine	22° 21'	91.96'
Remon. tag in E side 8" Pine	29° 33'	82.43'
Remon. tag in W side 8" Pine	143° 44'	92.75'
Remon. tag in W side 8" Pine	142° 21'	88.59'
Centerline E and W asphalt road and bridge	0°	0'

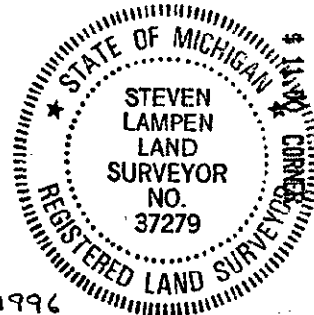

Signed by Steven Lampen Date DECEMBER 13, 1996  
Surveyor's Michigan License No. 37279

FORM APPROVED BY MICHIGAN STATE BOARD OF LAND SURVEYORS, JAN. 28, 1971  
REVISED MAY 14, 1976  
REVISED JAN., 1983  
ADAPTED FOR WORD PROCESSING MARCH, 1983

