SURVEY &
REMONUMENTATION

APR 2 4 1995

COMMISSION

RECORDED

94 DEC 14 AM 9:41

REGISTER OF DEEDS
OTTAWA COUNTY, MI

OTTAWA COUNTY REMONUMENTATION
LAND CORNER RECORDATION CERTIFICATE
Filing Requirement of Act 74, Mich. P.A. 1970

For corners in

Ottawa (County)

	Located In:	Corner Code #
1. Public Land Survey	T 5N R 16W	L-9 (N1/4 Cor Sec 25)
	T ___ R ___	Park Twp.
	T ___ R ___	
	T ___ R ___	
2. Property Controlling	S ___ T ___ R ___	
in Section	S ___ T ___ R ___	
3. Miscellaneous	S ___ T ___ R ___	
Property in Sec.	S ___ T ___ R ___	

Register of Deeds Stamp & File Number

4. Lot No. _____ , Recorded Plat _____
5. Private Claims _____

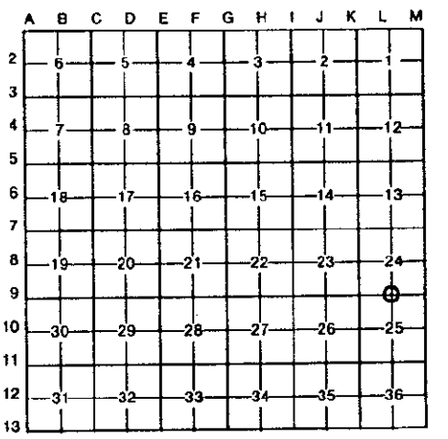

I, John P. Clapp, in a field survey on November 30, 19 94, do hereby certify that under requirements of P.A. 74, Michigan P.A. of 1970, the corner points mentioned in lines 1 and 2 above were in conformance with regulations and rules therefore as required in the current manual of survey instructions of the United States Department of the Interior, Bureau of Land Management or by a decree of a Court of Law and/or that the corner points mentioned in lines 3, 4 and 5 above were in conformance with the rules of the Michigan Board of Land Surveyors or by a Decree of a Court of Law; established, re-established, monumented, re-monumented, recovered, found as expressed below:

NOTE: Not more than 4 corners, all in the same town and range, may be recorded on this certificate.

A. Description of original monument and accessories and/or subsequent restoration:

L-9
Govt Land Office Survey Notes
1832-Surveyor, Calvin Britain
Post
10" Cedar N75°W 41 links
11" Cedar S75°E 33 links

L-9
Recorded in Liber 1, Page 387
May 11, 1972
Set angle iron midway on line
between K-9 and M-9

B. Description of corner evidence found and/or method applied in restoring or reestablishing corner:

L-9
Found P.K. nail over steel bar over angle iron and accepted it as a careful and faithful perpetuation of the position of the original corner

Back of Curb	S	1.38'
Found Nail in S Side Power Pole	AZ 74°	63.14'

P.A. 345 OTTAWA COUNTY
PEER APPROVED 12/12/94
Gordon P. Nedeweld

C. Description of monument for corner and accessories established to perpetuate locating the position of the corner:

L-9
Set O.C. Remon Cap & Iron in Concrete and Set Monument Box Over It

Set O.C. Remon Tag & Nail NW Side 42" Willow	AZ.	51°	101.84'
Set O.C. Remon Tag & Nail NE Side 12" Tw Poplar	AZ.	134°	108.38'
Set O.C. Remon Tag & Nail NW Side 6" White Pine	AZ.	197°	83.54'
Set O.C. Remon Tag & Nail SW Side 33" Oak	AZ.	307°	80.83'

STATE OF MICHIGAN
JOHN P. CLAPP
LAND SURVEYOR
NO. 14091
REGISTERED LAND SURVEYOR

Signed by John P. Clapp Date Dec. 2, 1994

Surveyor's Michigan License No. 14091

FORM APPROVED BY MICHIGAN STATE BOARD OF LAND SURVEYORS, JAN. 28, 1971
REVISED MAY 14, 1975
REVISED JAN., 1983

W:\Docs\Surv\Remon.doc