

FEB 24 2000

RECORDED

OTTAWA COUNTY REMONUMENTATION
LAND CORNER RECORDATION CERTIFICATE
Filing Requirement of Act 74, Mich. P.A. 1970

99 OCT 27 PM 1:48

Harry Subbitt
REGISTER OF DEEDS
OTTAWA COUNTY, MI

For corners in
Ottawa
 (County)

Located In: _____ Corner Code # _____

1. Public Land Survey T5N R16W L-11
 T R
 T R North 1/4 corner
 T R Section 36
 Park Township

2. Property Controlling S T R
 in Section S T R
 3. Miscellaneous S T R
 Property in Sec. S T R

Register of Deeds Stamp & File Number


4. Lot No. _____, Recorded Plat _____
 5. Private Claims _____

	A	B	C	D	E	F	G	H	I	J	K	L	M
1													
2	6	5	4	3	2	1							
3													
4	7	8	9	10	11	12							
5													
6	18	17	16	15	14	13							
7													
8	19	20	21	22	23	24							
9													
10	30	29	28	27	26	25							
11													
12	31	32	33	34	35	36							
13													

I, Steve Lampen, in a field survey on September 18, 1999, do hereby certify that under requirements of P.A. 74, Michigan P.A. of 1970, the corner points mentioned in lines 1 and 2 above were in conformance with regulations and rules therefore as required in the current manual of survey instructions of the United States Department of the Interior, Bureau of Land Management or by a decree of a Court of Law and/or that the corner points mentioned in lines 3, 4 and 5 above were in conformance with the rules of the Michigan Board of Land Surveyors or by a Decree of a Court of Law; established, re-established, monumented, re-monumented, recovered, found as expressed below:

NOTE: Not more than 4 corners, all in the same town and range, may be recorded on this certificate.

A. Description of original monument and accessories and/or subsequent restoration:
 L-11 West corrected West
 GLO - Brookfield - 1832 39.95 1/4 sec. post in lake
 East on ran between Sections 25 & 36 72.59 left lake and set meander post
 6.31 to lake W Oak 10 N 52 W 13
 40.00 temp. 1/4 sec. post in lake Dogwood 7 S 49 W 7
 79.90 East boundary 20 N of post in lake 79.90 section corner lake

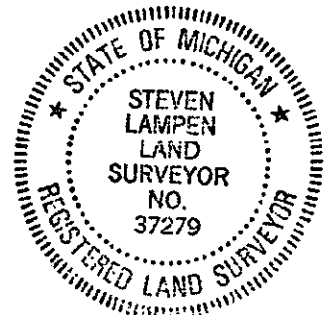

B. Description of corner evidence found and/or method applied in restoring or reestablishing corner:
 L-11 Found no field evidence or survey record that the original GLO post had ever been located.

Re-Established the position of L-11 by single proportionate measurement between K-11 and M-11 and is Accepted as a careful and faithful re-establishment of the position of the original corner.

9/20/99
SL

C. Description of monument for corner and accessories established to perpetuate locating the position of the corner:
 L-11 Corner falls in Lake Macatawa Azimuth = Michigan State Plan grid direction
 L-11 is calculated position mid-way and on line between K-11 (Remon. Liber 3, Page 431) and M-11 (Remon. Liber 3, Pages 639 and 641).

K-11	271° 00' 34"	2647.06
M-11	91° 00' 34"	2647.06
L-9	0° 47'	5313.35
L-13	180° 10'	5300.08

\$9.00 CORNER
Receipt #61757

Signed by Steven Lampen

Date OCTOBER 18, 1999

Surveyor's Michigan License No. 37279