

SURVEY & REMONUMENTATION

APR 05 1996

COMMISSION

**OTTAWA COUNTY REMONUMENTATION
LAND CORNER RECORDATION CERTIFICATE**
Filing Requirement of Act 74, Mich. P.A. 1970

For corners in
Ottawa
(County)

Located In:

Corner Code #

- | | | |
|------------------------------------|----------------------|---------------------|
| 1. Public Land Survey | T5N R16W | M-2 |
| | T_____ R_____ | E 1/4 cor. Sec. |
| | T_____ R_____ | <u>1, Park Twp.</u> |
| | T_____ R_____ | _____ |
| 2. Property Controlling in Section | S_____ T_____ R_____ | _____ |
| | S_____ T_____ R_____ | _____ |
| 3. Miscellaneous Property in Sec. | S_____ T_____ R_____ | _____ |
| | S_____ T_____ R_____ | _____ |

RECORDED

95 NOV 15 PM 2:08

Deborah A. Hollman
REGISTER OF DEEDS
OTTAWA COUNTY, MI

Register of Deeds Stamp & File Number

4. Lot No. _____, Recorded Plat _____
5. Private Claims _____

I, Steven Lampen, in a field survey on October 12, 1995, do hereby certify that under requirements of P.A. 74, Michigan P.A. of 1970, the corner points mentioned in lines 1 and 2 above were in conformance with regulations and rules therefore as required in the current manual of survey instructions of the United States Department of the Interior, Bureau of Land Management or by a decree of a Court of Law and/or that the corner points mentioned in lines 3, 4 and 5 above were in conformance with the rules of the Michigan Board of Land Surveyors or by a Decree of a Court of Law; established, re-established, monumented, re-monumented, recovered, found as expressed below:

A	B	C	D	E	F	G	H	I	J	K	L	M
1												
2	6	5	4	3	2	1						
3												
4	7	8	9	10	11	12						
5												
6	18	17	16	15	14	13						
7												
8	19	20	21	22	23	24						
9												
10	30	29	28	27	26	25						
11												
12	31	32	33	34	35	36						
13												

NOTE: Not more than 4 corners, all in the same town and range, may be recorded on this certificate.

A. Description of original monument and accessories and/or subsequent restoration:

GLO April 1832 Surveyor - Calvin Britain Set Post Br Ash 8 N 57W 2.02'	LCRC L 1-P 79 Power pole Power pole NW Bridge rail post Power pole Holland Twp. corner is N 25.00'	LCRC L 5-P 279 Nail in wood fence corner Holland Twp. corner	ENE 87.60' N 25.00'
--	---	--	------------------------

B. Description of corner evidence found and/or method applied in restoring or reestablishing corner:

Found CIM in monument box and is accepted as a careful and faithful perpetuation of the position of the original corner.


Power pole 152.79'	Nail in wood fence corner ENE 87.60'
Power pole 104.04'	Holland Twp. corner N 25.00'
Power pole 205.05'	
Holland Twp. corner is North 25.00'	

P.A. 345 OTTAWA COUNTY
PEER APPROVED 10/23/95

Victory P. Newbold
YDN

C. Description of monument for corner and accessories established to perpetuate locating the position of the corner:

CIM in monument box	AZ = MI state plan grid direction
M-1 T5N, R16W	359° 05' 19"
A-2 T5N, R15W	359° 05' 19" 25.00'
Centerline asphalt pavement	90° 4'
Remon. tag N side power pole	274° 25' 104.56'
Remon. tag NE side power pole	317° 47' 153.19'
centerline top hydrant	30° 13' 71.31'
centerline top hydrant	130° 40' 56.18'
"+" cut in middle CMP	197° 57' 116.82'
"+" cut in middle CMP	170° 00' 175.26'

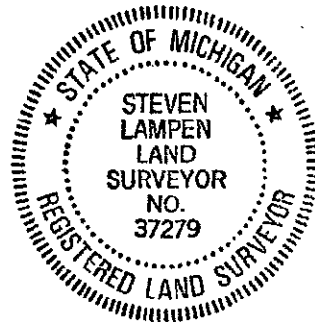

Signed by Steven Lampen

Date October 12, 1995

Surveyor's Michigan License No. 37279

FORM APPROVED BY MICHIGAN STATE BOARD OF LAND SURVEYORS, JAN. 28, 1971
REVISED MAY 14, 1976
REVISED JAN., 1983
ADAPTED FOR WORD PROCESSING MARCH, 1993