

**SURVEY & REMONUMENTATION**

APR 05 1996

COMMISSION

OTTAWA COUNTY REMONUMENTATION  
 LAND CORNER RECORDATION CERTIFICATE  
 Filing Requirement of Act 74, Mich. P.A. 1970

*Sequence # 2*

For corners in Ottawa (County)	Located In:	Corner Code #
1. Public Land Survey	T5N R16W	M-10
	T _____ R _____	(E 1/4 cor Sec.
	T _____ R _____	25, Park Twp.)
	T _____ R _____	_____
2. Property Controlling in Section	S _____ T _____ R _____	_____
	S _____ T _____ R _____	_____
3. Miscellaneous Property in Sec.	S _____ T _____ R _____	_____
	S _____ T _____ R _____	_____

RECORDED

95 NOV 15 PM 2:08

*Polycia Ballman*  
 REGISTER OF DEEDS  
 OTTAWA COUNTY, MI

Register of Deeds Stamp & File Number

4. Lot No. \_\_\_\_\_, Recorded Plat \_\_\_\_\_  
 5. Private Claims \_\_\_\_\_

I, Steven Lampen, In a field survey on October 12, 1995, do hereby certify that under requirements of P.A. 74, Michigan P.A. of 1970, the corner points mentioned in lines 1 and 2 above were in conformance with regulations and rules therefore as required in the current manual of survey instructions of the United States Department of the Interior, Bureau of Land Management or by a decree of a Court of Law and/or that the corner points mentioned in lines 3, 4 and 5 above were in conformance with the rules of the Michigan Board of Land Surveyors or by a Decree of a Court of Law; established, re-established, monumented, re-monumented, recovered, found as expressed below:

	A	B	C	D	E	F	G	H	I	J	K	L	M
1													
2	6	5	4	3	2	1							
3													
4	7	8	9	10	11	12							
5													
6	18	17	16	15	14	13							
7													
8	19	20	21	22	23	24							
9													
10	30	29	28	27	26	25							
11													
12	31	32	33	34	35	36							
13													

NOTE: Not more than 4 corners, all in the same town and range, may be recorded on this certificate.

A. Description of original monument and accessories and/or subsequent restoration:

<b>M-10</b>		
GLO - 1831	LCRC L 6-P 265	
Surveyor - Lucius Lyon	NW corner of porch foundation	302° 50' 108.86'
12" W. Oak N 20° W 11'	SW corner of brick house	54° 53' 106.71'
12" W. Oak S 40° W 20'	NE corner of house foundation	119° 50' 111.56'
	NW corner of brick house	250° 10' 135.16'

B. Description of corner evidence found and/or method applied in restoring or reestablishing corner:

**M-10**  
 Found CIM and is accepted as a careful and faithful perpetuation of the position of the original corner.

	<b>AZ</b>	
	NW corner of porch foundation	302° 50' 108.86'
12" W. Oak N 20° W 11'	SW corner of brick house	54° 53' 106.71'
12" W. Oak S 40° W 20'	NE corner of house foundation	119° 50' 111.56'
	NW corner of brick house	250° 10' 135.16'

P.A. 345 OTTAWA COUNTY  
 PEER APPROVED 10/23/95

*Wesley D. Hedewell*  
 SDN


C. Description of monument for corner and accessories established to perpetuate locating the position of the corner:

<b>M-10</b>	<b>AZ</b>	
CIM	NW corner of porch foundation	302° 59' 108.86'
	SW corner of brick house	54° 53' 106.71'
	NE corner of house foundation	119° 50' 111.56'
	NW corner of brick house	250° 10' 135.16'

This monument fits the six adjacent plats: Oosting's Subd., Hyma's Supervisor's Resubd., Oaklawn Park, Ingleside Plat, Heneveld's Supervisor's Plats 15 and 16.  
 Historically there is no jog at this corner.

Signed by Steven Lampen  
 Surveyor's Michigan License No. 37279

Date October 23, 1995

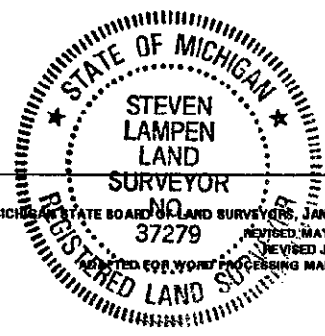

FORM APPROVED BY MICHIGAN STATE BOARD OF LAND SURVEYORS, JAN. 23, 1971  
 REVISED MAY 14, 1975  
 REVISED JAN., 1983  
 ADAPTED FOR WORD PROCESSING MARCH, 1993