

**SURVEY &  
REMONUMENTATION**

APR 05 1996

**COMMISSION**

**OTTAWA COUNTY REMONUMENTATION  
LAND CORNER RECORDATION CERTIFICATE**  
Filing Requirement of Act 74, Mich. P.A. 1970

For corners in <u>Ottawa</u> (County)	Located In:	Corner Code #
1. Public Land Survey	T5N R16W	M-12
	T _____ R _____	(E 1/4 cor. Sec.
	T _____ R _____	36, Park Twp.)
	T _____ R _____	_____
2. Property Controlling in Section	S _____ T _____ R _____	_____
	S _____ T _____ R _____	_____
3. Miscellaneous Property in Sec.	S _____ T _____ R _____	_____
	S _____ T _____ R _____	_____

**RECORDED**

95 NOV 15 PM 2:09

REGISTER OF DEEDS  
OTTAWA COUNTY, MI

Register of Deeds Stamp & File Number

4. Lot No. \_\_\_\_\_, Recorded Plat \_\_\_\_\_  
5. Private Claims \_\_\_\_\_

I, Steven Lampen \_\_\_\_\_, in a field survey on October 23 1995, do hereby certify that under requirements of P.A. 74, Michigan P.A. of 1970, the corner points mentioned in lines 1 and 2 above were in conformance with regulations and rules therefore as required in the current manual of survey instructions of the United States Department of the Interior, Bureau of Land Management or by a decree of a Court of Law and/or that the corner points mentioned in lines 3, 4 and 5 above were in conformance with the rules of the Michigan Board of Land Surveyors or by a Decree of a Court of Law; established, re-established, monumented, re-monumented, recovered, found as expressed below:

1	A	B	C	D	E	F	G	H	I	J	K	L	I
2	6	5	4	3	2	1							
3													
4	7	8	9	10	11	12							
5													
6	18	17	16	15	14	13							
7													
8	19	20	21	22	23	24							
9													
10	30	29	28	27	26	25							
11													
12	31	32	33	34	35	36							
13													

**NOTE: Not more than 4 corners, all in the same town and range, may be recorded on this certificate.**

**A. Description of original monument and accessories and/or subsequent restoration:**

M-12  
GLO Survey Notes  
1832, Surveyor - Sylvester Sibley  
Set 1/2 mile post  
22" Beech S 32° W 36 links  
32" Beech N 62° W 33 links

No LCRC recorded

**B. Description of corner evidence found and/or method applied in restoring or reestablishing corner:**


M-12  
Found 1/2 rebar and is accepted as a careful and faithful perpetuation of the position of the original corner. This corner, as M-12, T5N, R16W fits the recorded plats of Heneveld's Supervisor's Plat No. 13 and Sunset Terrace. This corner as A-12, T5N, R15W fits the recorded plat of Plasman's Subd., recorded Surveys in L 1-P772, L 2-P 28, L 3-P 31 and a survey by Emmet Peck in October 1899.

PA. 345 OTTAWA COUNTY  
PEER APPROVED 10/23/95

*Heidy P. Nedwell*  
907

**C. Description of monument for corner and accessories established to perpetuate locating the position of the corner:**

<u>M-12</u> Set Remon. in set monument box	AZ = MI State Plane grid direction	
SE corner house, brick	47° 01'	161.89'
NW corner brick wall on church	128° 18'	175.84'
SE corner house, brick	235° 18'	109.62'
NE corner brick porch	252° 31'	92.27'
SE corner house, stone	297° 17'	97.38'
NE corner house, stone	320° 06'	143.37'
Centerline Graafschap & 24th St.	0° 14' 20"	33.0'

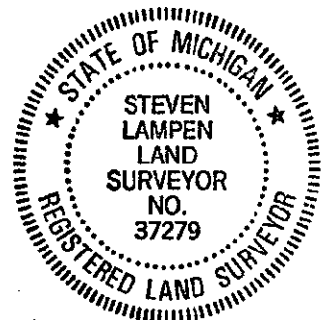

Signed by Steven Lampen Date October 23, 1995

Surveyor's Michigan License No. 37279