

**SURVEY &
REMONUMENTATION**

OTTAWA COUNTY REMONUMENTATION
LAND CORNER RECORDATION CERTIFICATE
Filing Requirement of Act 74, Mich. P.A. 1970

FEB 27 1998

For corners in **SECTION**

Ottawa (County) Located In: Corner Code #

1. Public Land Survey T5N R16W M-11, 12
T R NE cor. Sec. 36
T R Park Twp.
T R

2. Property Controlling S36 T5N R16W
in Section S T R
3. Miscellaneous S T R
Property in Sec. S T R

**SEQUENTIAL
CORNER #1**

RECORDED
97 DEC -8 AM 11:33

Stan Sibley
REGISTER OF DEEDS
OTTAWA COUNTY, MI

Register of Deeds Stamp & File Number

4. Lot No. _____, Recorded Plat _____
5. Private Claims _____

I, Steven Lampen, in a field survey on November 17 19 97, do hereby certify that under requirements of P.A. 74, Michigan P.A. of 1970, the corner points mentioned in lines 1 and 2 above were in conformance with regulations and rules therefore as required in the current manual of survey instructions of the United States Department of the Interior, Bureau of Land Management or by a decree of a Court of Law and/or that the corner points mentioned in lines 3, 4 and 5 above were in conformance with the rules of the Michigan Board of Land Surveyors or by a Decree of a Court of Law, established, re-established, monumented, re-monumented, recovered, found as expressed below:

NOTE: Not more than 4 corners, all in the same town and range, may be recorded on this certificate.

A. Description of original monument and accessories and/or subsequent restoration:

G.L.O.
1832 Sibley, Britain
North on the East side of Section 36
40.00 set a 1/4 section post
70.30 to a lake set post
Hemlock 7" S 10 W 17 links
Do 9" S 72 E 16 1/2 links
80.00' corner to 25 and 36 in lake

GLO for T.5N, R.15W, - Britain - 1832
West between Section 30 & 31
40.00 set HMP
71.12 Black River Lake and set meander post
82.89 West boundary 36 South of post and set cor in Lake to Section 30 & 31

Section line between 36 and Sec. 31, T5N, R15W, is shown on plats Sunset Terrace 1921, Heneveld's Supervisor's Plat No. 13, 1934, Apple Hill Subdivision 1978

B. Description of corner evidence found and/or method applied in restoring or reestablishing corner:

M-11
Found no evidence or survey record that M-11 had ever been located since the original G.L.O. survey. Calculated position of M-11 by using single proportionate measurement using corners M-10 and M-12 Re-established township line between Section 36 and Section 31, Town 5 North, Range 15 West by using the Plats listed in A for East and West location and proportioned the G.L.O. measurement for North and South location.

See Sketch on back. Set Ottawa County Remonumentation iron and cap at the recorded G.L.O. meander post position on the South side of Lake Macatawa on the section line between sections 36 and 31.

Calculated position of M-11 and the Section line between Sections 36 and 31 are accepted as a careful and faithful re-establishment of the position of the original corner.


P.A. 345 OTTAWA COUNTY
PEER APPROVED 12-1-97

S.D.N.

C. Description of monument for corner and accessories established to perpetuate locating the position of the corner:

M-11 - Reference Monument
Ottawa County Remonumentation iron and cap at G.L.O. meander post position on South side of Lake Macatawa
AZ = Michigan State Plane grid direction

NW corner house stone	130° 40'	70.51'
NE corner house stone	93° 14'	101.34'
NE corner concrete seawall	10° 10'	44.85'
NW corner concrete seawall	328° 16'	31.25'
NE corner house wood siding	226° 18'	95.39'
M-11	0° 47' 25"	643.67'
M-10	180° 14' 20"	2010.65'

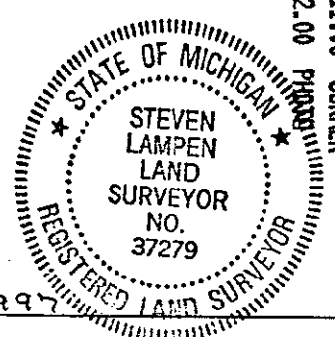

Signed by Steven Lampen Date DECEMBER 1, 1997
Surveyor's Michigan License No. 37279

FORM APPROVED BY MICHIGAN STATE BOARD OF LAND SURVEYORS, JAN. 28, 1971

SECTION
25

SECTION
30

LAKE

MACATAWA



M-10

0°44'45"
946.93

GLO M.P.
SET. REMON.

0°47'25" 1707.39

0°47'25"
643.67

GLO M.P.
SET REMON

SECTION
36

SECTION
31

2010.65

1:00° 14' 20"

M-12

SURVEY &
REMONUMENTATION

FEB 27 1998

SECTION

4822 0.0000
7119 10.000