

SURVEY & REMONUMENTATION

DEC 01 1998

Ottawa County Remonumentation
LAND CORNER RECORDATION CERTIFICATE 98 MAY 22 PM 4: 06
 Filing Requirement of Act 74, Mich. P.A. 1970

RECORDED

SECTION

For corners in

<u>Ottawa</u> (County)	Located In:	Corner Code #
1. Public Land Survey	T <u>6N</u> R <u>13W</u>	<u>A-2</u> (W $\frac{1}{4}$, 6) Georgetown Twp.
	T _____ R _____	_____
	T _____ R _____	_____
	T <u>6N</u> R <u>14W</u>	<u>M-2</u>
2. Property Controlling in Section	S _____ T _____ R _____	_____
	S _____ T _____ R _____	_____
3. Miscellaneous Property in Sec.	S _____ T _____ R _____	_____
	S _____ T _____ R _____	_____
4. Lot No. _____, Recorded Plat _____		
5. Private Claims _____		

Sam [Signature]
 REGISTER OF DEEDS
 OTTAWA COUNTY, MI

Register of Deeds Stamp & File Number

I, John C. Bueche, in a field survey on March 2, 19 98, do hereby certify that under requirements of P.A. 74, Michigan P.A. of 1970, the corner points mentioned in lines 1 and 2 above were in conformance with regulations and rules therefore as required in the current manual of survey instructions of the United States Department of the Interior, Bureau of Land Management or by a decree of a Court of Law and/or that the corner points mentioned in lines 3, 4 and 5 above were in conformance with the rules of the Michigan Board of Land Surveyors or by a Decree of a Court of Law; established, re-established, monumented, re-monumented, recovered, found as expressed below:

A	B	C	D	E	F	G	H	I	J	K	L	M
2	6	5	4	3	2	1						
3												
4	7	8	9	10	11	12						
5												
6	18	17	16	15	14	13						
7												
8	19	20	21	22	23	24						
9												
10	30	29	28	27	26	25						
11												
12	31	32	33	34	35	36						
13												

NOTE: Not more than 4 corners, all in the same town and range, may be recorded on this certificate.

A. Description of original monument and accessories and/or subsequent restoration:

A-2 GLO LCRC Remon. L3-P568, Dec., 1997
 Did not Found cast iron mon. in Mon. Box
 set corner Ottawa Co. Remon. Tag & Nail in E side Pole N 28° E 93.96'
 Ottawa Co. Remon. Tag & Nail in NE side 22" Maple N 44° W 40.91'
 Ottawa Co. Remon. Tag & Nail in S side 16" Hickory S 73° W 89.66'
 Ottawa Co. Remon. Tag & Nail in S side 18" Hickory N 77° W 96.34'
 C/L gravel rd. W is N 2'±; on C/L bit. N-S
 Tree & brush row E is S 3'±

This is common to M-2 (W 1/4 Sec. 1, 6-14) Corners N & S are common

B. Description of corner evidence found and/or method applied in restoring or reestablishing corner:

A-2 Found cast iron mon. in Mon. Box

As per above wit.


PA. 345 OTTAWA COUNTY
 PEER APPROVED 4/20/98

[Signature]

This position not established by original government surveyors.
 This monument is accepted as the best available evidence of the position of the corner.

C. Description of monument for corner and accessories established to perpetuate locating the position of the corner:

A-2 Cast iron mon. in Mon. Box
 Ottawa Co. Remon. Tag & Nail in E side Pole N 28° E 93.96'
 Ottawa Co. Remon. Tag & Nail in NE side 22" Maple N 44° W 40.91'
 Ottawa Co. Remon. Tag & Nail in S side 18" Hickory N 77° W 96.34'
 Set new Ottawa Co. Remon. Tag & Nail in S side 16" Hickory S 73° W 89.40'
 Set Ottawa Co. Remon. Tag & Nail in N side 14" Maple N 90° E 83.90'
 C/L gravel rd. W is N 2'±; on C/L bit. N-S
 Tree & brush row E is S 3'±

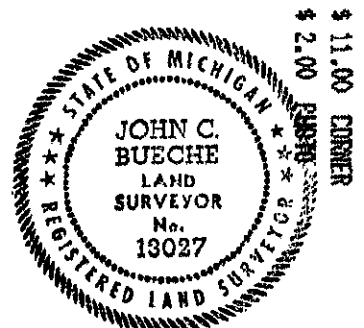

Signed by John C. Bueche
 John C. Bueche, P.S. 13027
 Surveyor's Michigan License No. _____

Date 3-13-98

SURVEY &
REMONUMENTATION

DEC 01 1998

SECTION

