

FEB 24 2000

RECORDED

OTTAWA COUNTY REMONUMENTATION 99 JUL 30 PM 12: 26
LAND CORNER RECORDATION CERTIFICATE
Filing Requirement of Act 74, Mich. P.A. 1970

Dan Schmitt
REGISTER OF DEEDS
OTTAWA COUNTY, MI

SECTION

For corners in

<u>OTTAWA</u> (County)	Located in:	Corner Code #
1. Public Land Survey	T <u>6N</u> R <u>13W</u>	A-5 NW cor Sec. 18
	T ___ R ___	Georgetown-Twp
	T ___ R ___	_____
	T ___ R ___	_____
2. Property Controlling in Section	S ___ T ___ R ___	_____
	S ___ T ___ R ___	_____
3. Miscellaneous Property in Sec.	S ___ T ___ R ___	_____
	S ___ T ___ R ___	_____

Register of Deeds Stamp & File Number

4. Lot No. _____, Recorded Plat _____
5. Private Claims _____

I, Randal J. Vugteveen, in a field survey on March 16, 19 99 do hereby state that under requirements of P.A. 74, Michigan P.A. of 1970, the corner points mentioned in lines 1 and 2 above were in conformance with regulations and rules therefore as required in the current manual of survey instructions of the United States Department of the Interior, Bureau of Land Management or by a decree of a Court of Law and for that the corner points mentioned in lines 3, 4 and 5 above were in conformance with the rules of the Michigan Board of Land Surveyors or by a Decree of a Court of Law; established, re-established, monumented, recovered, found as expressed below.

NOTE: Not more than 2 corners, all in the same town and range, may be recorded on this certificate.

A	B	C	D	E	F	G	H	I	J	K	L	M
1												
2	6		5		4		3		2		1	
3												
4	7		8		9		10		11		12	
5												
6	18		17		16		15		14		13	
7												
8	19		20		21		22		23		24	
9												
10	30		29		28		27		26		25	
11												
12	31		32		33		34		35		36	
13												

A. Description of original monument and accessories and/or subsequent restoration:

A-5 GLO 1832
Lucius Lyon D.S.
Set Post 7 Links N. of Post
6" Beech S33°E 20 Links
7" Beech N22°E 15 Links

A-5 Liber 2 Page 397
Englert 1973
Found Angle Iron
W 33.55' Telephone Pole
E 65.29' Power Pole
NW 87.35' Twin Cherry
NE 84.81' 12" Pine

A-5 Liber 3 Page 80
Greer 1976
Fd "T" set Cast Iron Mon.
P. Pole S86°E 65.23'
NE hse cor S48°W 156.47'
Tel. Pole N88°W 33.57'
12" Twin Cherry N35°W 87.36'
Blendon Cor. S 4.62'

B. Description of corner evidence found and/or method applied in restoring or reestablishing corner:

A-5 Found Cast Iron Monument in Mon Box

Found Remon Tag & Nail N side PP S86°W 33.57'
Found NE Hse Cor Hse #8021 S43°W 156.46'
Found Cast Iron Mon. (Blendon Cor.) South 4.62'


Accepted Cast Iron Monument as a careful and faithful perpetuation of the position of the original corner.

OTTAWA COUNTY
RECORDED 3/22/99
YDM

C. Description of monument for corner and accessories established to perpetuate locating the position of the corner.

A-5 Cast Iron Monument in Mon. Box 0.08' East of Town Line, Witnesses are to Monument

Found Cast Iron Mon. (Blendon Cor) South 4.62'
Set Remon Tag & Nail NW side 24" Pine N56°E 85.03'
Set Remon Tag & Nail N side Power Pole 90° East 46.78'
Set Remon Tag & Nail NW side 20" Maple S28°W 108.02'
Found NE Hse Cor Hse #8021 S43°W 156.46'
on centerline of Blacktop N & S Road

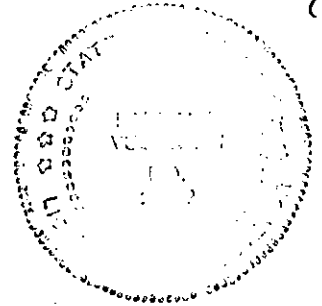

\$11.00 CORNER
Receipt #52389

Signed by *Randal J. Vugteveen*
Surveyor's Michigan License No. 28429

Date MARCH 16, 1999

SURVEY &
RF

FEB 24 2000

SECTION

BLENDON TWP.

Georgetown TWP.

