

FEB 24 2000

RECORDED

SECTION

OTTAWA COUNTY REMONUMENTATION

99 JUL 30 PM 12: 26

LAND CORNER RECORDATION CERTIFICATE
Filing Requirement of Act 74, Mich. P.A. 1970

Randy Schell
REGISTER OF DEEDS
OTTAWA COUNTY, MI

For corners in
OTTAWA
(County)

	Located In:	Corner Code #
1. Public Land Survey	T 6N R 13W	A-6 W 1/4 Sec 18
	T R	Georgetown Twp.
	T R	
	T R	
2. Property Controlling in Section	S T R	
	S T R	
3. Miscellaneous Property in Sec.	S T R	
	S T R	

Register of Deeds Stamp & File Number

4. Lot No. _____, Recorded Plat _____
5. Private Claims _____

I, Randal J. Vugteveen, in a field survey on March 16, 1999 do hereby state that under requirements of P.A. 74, Michigan P.A. of 1970, the corner points mentioned in lines 1 and 2 above were in conformance with regulations and rules therefore as required in the current manual of survey instructions of the United States Department of the Interior, Bureau of Land Management or by a decree of a Court of Law and for that the corner points mentioned in lines 3, 4 and 5 above were in conformance with the rules of the Michigan Board of Land Surveyors or by a Decree of a Court of Law, established, re-established, monumented, recovered, found as expressed below:

NOTE: Not more than 2 corners, all in the same town and range, may be recorded on this certificate.

A	B	C	D	E	F	G	H	I	J	K	L	M
1												
2	6	5	4	3	2	1						
3												
4	7	8	9	10	11	12						
5												
6	18	17	16	15	14	13						
7												
8	19	20	21	22	23	24						
9												
10	30	29	28	27	26	25						
11												
12	31	32	33	34	35	36						
13												

A. Description of original monument and accessories and/or subsequent restoration:

Corner not set by GLO

Liber 1 Page 723
Spicer 1972
Found 3/4" Solid Iron in Mon. Box
MBT Pole S30°E 63.15'
CP Pole N40°E 39.05'
CP Pole S52°E 50.8'
in Centerline X of Roads

M-6 T6N R14W Liber 1 Page 783
Found Mon Box
T Pole SE 63.18'
P Pole SW 50.44'
P Pole NE 39.0'
T Pole NW 64.04'

B. Description of corner evidence found and/or method applied in restoring or reestablishing corner:

A-6 Found Cast Iron Monument in Mon Box

On Centerline of E & W and N & S roads

This position not established by original government surveyors. Accepted Cast Iron Monument as the best available evidence of the position of the corner.


C. Description of monument for corner and accessories established to perpetuate locating the position of the corner:

A-6 Found Cast Iron Monument in Mon. Box

Found Remon Tag & Nail SE side Power Pole N43°E 43.71'
Found Remon Tag & Nail SW side Power Pole N16°W 155.81'
Found Remon Tag & Nail E side Power Pole S22°W 113.61'
Set Remon Tag & Nail E side Power Pole S8°E 179.22'
On Centerline of E & W and N & S roads +/-
This corner is common to M-6, T6N, R14W

Signed by *Randal J. Vugteveen*
Surveyor's Michigan License No. 28429

Date MARCH 16, 1999

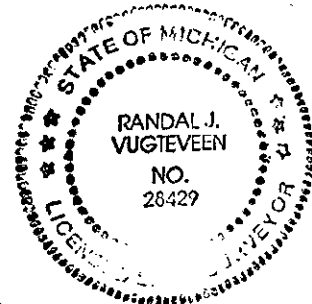

\$11.00 CORNER
Receipt #52389

RECORDED
 FEB 24 2000
 SECTION

