

**SURVEY & REMONUMENTATION**

DEC 01 1998

Ottawa County Remonumentation  
**LAND CORNER RECORDATION CERTIFICATE**  
 Filing Requirement of Act 74, Mich. P.A. 1970

**RECORDED**  
 98 MAY 22 PM 4:06

**SECTION**

For corners in

<u>Ottawa</u> (County)	Located In:	Corner Code #
1. Public Land Survey	T <u>6N</u> R <u>13W</u>	A-8 (W $\frac{1}{2}$ , 19) Georgetown Twp.
	T _____ R _____	_____
	T _____ R _____	_____
2. Property Controlling in Section	S _____ T _____ R _____	_____
	S _____ T _____ R _____	_____
3. Miscellaneous Property in Sec.	S _____ T _____ R _____	_____
	S _____ T _____ R _____	_____
4. Lot No. _____, Recorded Plat _____		
5. Private Claims _____		

*James Schell*  
 REGISTER OF DEEDS  
 OTTAWA COUNTY, MI

Register of Deeds Stamp & File Number

I, John C. Bueche, in a field survey on March 12, 19 98, do hereby certify that under requirements of P.A. 74, Michigan P.A. of 1970, the corner points mentioned in lines 1 and 2 above were in conformance with regulations and rules therefore as required in the current manual of survey instructions of the United States Department of the Interior, Bureau of Land Management or by a decree of a Court of Law and/or that the corner points mentioned in lines 3, 4 and 5 above were in conformance with the rules of the Michigan Board of Land Surveyors or by a Decree of a Court of Law; established, re-established, monumented, re-monumented, recovered, found as expressed below:

	A	B	C	D	E	F	G	H	I	J	K	L	M
2	6	5	4	3	2	1							
3													
4	7	8	9	10	11	12							
5													
6	18	17	16	15	14	13							
7													
8	19	20	21	22	23	24							
9													
10	30	29	28	27	26	25							
11													
12	31	32	33	34	35	36							

**NOTE: Not more than 4 corners, all in the same town and range, may be recorded on this certificate.**

A. Description of original monument and accessories and/or subsequent restoration:

A-8 GLO	LCRC L3, P80, April, 1976	Focus, no date
Did not set corner	Found crockery	N 14.62' Co.
	Set CI Mon.	N 70 W 35.48' PK in PP
	PP S 86 E 58.77'	S 85 E 58.93' PK in PP
	SW hse. fig. cor.	S 83 E 27.50' C/L hyd.
	S 50 E 143.29'	
	TP N 64 W 36.09'	
	Blendon cor. N 14.66'	

B. Description of corner evidence found and/or method applied in restoring or reestablishing corner:


A-8 Found 4" Harrison in bit. rd. (6" below grade) on East Line of Township  
 M-8 (E $\frac{1}{2}$ , 24) & M-9 (SE, 24) 6-14  
 As per above wit.

This position not established by original government surveyors.  
 This monument is accepted as the best available evidence of the position of the corner.

P.A. 345 OTTAWA COUNTY  
 PEER APPROVED 4/20/98

C. Description of monument for corner and accessories established to perpetuate locating the position of the corner:

A-8 4" Harrison Mon. in bit. (6" below grade)  
 SW cor. brick hse. #6790 S 45° E 143.38'  
 Ottawa Co. Remon. Tag & Nail in S side PP S 85° E 58.78'  
 Ottawa Co. Remon. Tag & Nail in N side PP N 60° W 35.88'  
 Ottawa Co. Remon. Tag & Nail in NW Twin 14" Oak S 35° W 75.31'  
 Top of hyd. S 83° E 27.33'  
 C/L bit. N-S is West 1'±, on tree row East  
 Blendon cor. M-8 North 14.66'

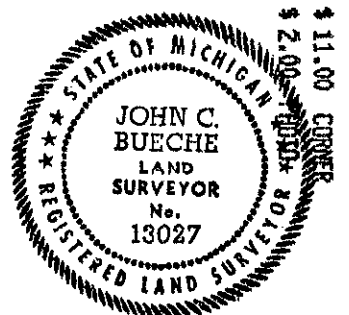

Signed by John C. Bueche  
 John C. Bueche, P.S. 13027  
 Surveyor's Michigan License No. \_\_\_\_\_

Date 3-13-98

SURVEY &  
REMONUMENTATION

DEC 01 1998

SECTION

