

SURVEY & REMONUMENTATION

FEB 18 1994

COMMISSION

**OTTAWA COUNTY REMONUMENTATION
LAND CORNER RECORDATION CERTIFICATE
Filing Requirement of Act 74, Mich. P.A. 1970**

RECORDED
93 NOV -8 PM 1:58

R. J. Hallman
REGISTER OF DEEDS
OTTAWA COUNTY, MI

For corners in

Ottawa
(County)

Located In:

Corner Code #

- | | | |
|------------------------------------|--------------------------|----------------------|
| 1. Public Land Survey | T <u>6N</u> R <u>13W</u> | <u>A-9, NW COR</u> |
| | T _____ R _____ | <u>Sec. 30, Genw</u> |
| | T _____ R _____ | _____ |
| | T _____ R _____ | _____ |
| 2. Property Controlling in Section | S _____ T _____ R _____ | _____ |
| | S _____ T _____ R _____ | _____ |
| 3. Miscellaneous Property in Sec. | S _____ T _____ R _____ | _____ |
| | S _____ T _____ R _____ | _____ |

Register of Deeds Stamp & File Number

4. Lot No. _____, Recorded Plat _____
5. Private Claims _____

	A	B	C	D	E	F	G	H	I	J	K	L	M
2	6	5	4	3	2	1							
3													
4	7	8	9	10	11	12							
5													
6	18	17	16	15	14	13							
7													
8	19	20	21	22	23	24							
9													
10	30	29	28	27	26	25							
11													
12	31	32	33	34	35	36							
13													

I, Randal D. Feenstra in a field survey on July 15, 19 93, do hereby certify that under requirements of P.A. 74, Michigan P.A. of 1970, the corner points mentioned in lines 1 and 2 above were in conformance with regulations and rules therefore as required in the current manual of survey instructions of the United States Department of the Interior, Bureau of Land Management or by a decree of a Court of Law and/or that the corner points mentioned in lines 3, 4 and 5 above were in conformance with the rules of the Michigan Board of Land Surveyors or by a Decree of a Court of Law; established, re-established, monumented, re-monumented, recovered, found as expressed below:

NOTE: Not more than 4 corners, all in the same town and range, may be recorded on this certificate.

A. Description of original monument and accessories and/or subsequent restoration:
A-9 - L.C.R.C.# L-5, P-118 Cast Iron Monument


- P.Pole SE 52.08'
- T.Pole NE 52.90'
- Lite Pole NW 62.73'
- Blendon Twp. Cor N12.53'
- SE Bldg. Cor. SW 120.40

3. Description of corner evidence found and/or method applied in restoring or reestablishing corner:

A-9 Found Cast Iron Monument in Box - accepted as a careful and faithful perpetuation of the position of the original corner.
Found all witnesses per Liber 5, Page 118, as listed above.

Description of monument for corner and accessories established to perpetuate locating the position of the corner:

- A-9. Cast Iron Monument in Box
- O.C. Remon. Nail & Tag in P.Pole SE 52.19'
 - O.C. Remon. Nail & Tag in T. Pole NE 52.95'
 - O.C. Remon. Nail & Tag in Lite Pole NW 62.59'
 - Blendon Township Corner NO°E 12.54'
- At CL 48th, 12.5' South of CL Port Sheldon

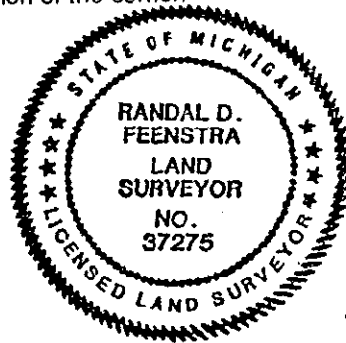

signed by

Randal D. Feenstra

Date

Sept. 29, 1993

Surveyor's Michigan License No.

37275