

**SURVEY & REMONUMENTATION**

JUN 28 1999

OTTAWA COUNTY REMONUMENTATION

RECORDED

98 NOV 11 PH 1:26

**LAND CORNER RECORDATION CERTIFICATE**  
Filing Requirement of Act 74, Mich. P.A. 1970

*Doug Scholtz*  
REGISTER OF DEEDS  
OTTAWA COUNTY, MI

**SECTION**

For corners in

OTTAWA

(County)

Located In:

Corner Code #

- |                                    |                          |                   |
|------------------------------------|--------------------------|-------------------|
| 1. Public Land Survey              | T <u>BN</u> R <u>13W</u> | B-7 N 1/4 Cor Sec |
|                                    | T ___ R ___              | 19 Wright Twp     |
|                                    | T ___ R ___              | _____             |
|                                    | T ___ R ___              | _____             |
| 2. Property Controlling in Section | S ___ T ___ R ___        | _____             |
|                                    | S ___ T ___ R ___        | _____             |
| 3. Miscellaneous Property in Sec.  | S ___ T ___ R ___        | _____             |
|                                    | S ___ T ___ R ___        | _____             |

Register of Deeds Stamp & File Number

4. Lot No. \_\_\_\_\_, Recorded Plat \_\_\_\_\_  
5. Private Claims \_\_\_\_\_

I, Randal J. Vugteveen, in a field survey on September 29, 19 98 do hereby state that under requirements of P.A. 74, Michigan P.A. of 1970, the corner points mentioned in lines 1 and 2 above were in conformance with regulations and rules therefore as required in the current manual of survey instructions of the United States Department of the Interior, Bureau of Land Management or by a decree of a Court of Law and/or that the corner points mentioned in lines 3, 4 and 5 above were in conformance with the rules of the Michigan Board of Land Surveyors or by a Decree of a Court of Law, established, re-established, monumented, recovered, found as expressed below:

	A	B	C	D	E	F	G	H	I	J	K	L	M
1													
2	6		5		4		3		2		1		
3													
4	7		8		9		10		11		12		
5													
6	18		17		16		15		14		13		
7													
8	19		20		21		22		23		24		
9													
10	30		29		28		27		26		25		
11													
12	31		32		33		34		35		36		
13													

NOTE: Not more than 2 corners, all in the same town and range, may be recorded on this certificate.

**A. Description of original monument and accessories and/or subsequent restoration:**

B-7 Set by GLO in 1837  
Set Quarter Section Post  
10" Sugar S20°E 11 Links  
12" Sugar N1°E 38 Links

Liber 5 Page 358  
Joiner Dec 5, 1988  
Set CIM  
PP SE 38.50'  
RR Tie set in Conc NW 51.50'  
Cut off TP NE 69.49'

**B. Description of corner evidence found and/or method applied in restoring or reestablishing corner:**

B-7 Found Cast Iron Monument box on Center of Blacktop Road

Found RR tie set in Conc N50°W 51.50'


Accepted Cast Iron Monument as a careful and faithful perpetuation of the position of the original corner.

P.A. 345 OTTAWA COUNTY  
PEER APPROVED 10/19/98

**C. Description of monument for corner and accessories established to perpetuate locating the position of the corner:**

B-7 Cast Iron Monument in Monument Box on Center of Blacktop Road

SW foundation cor to house # 4380 S20°E 148.50'  
Ottawa County Remon Tag and Nail NE side Power Pole S30°E 69.45'  
Ottawa County Remon Tag and Nail SW cor RR tie/ fence cor N50°W 51.50'  
ANR Gas Pipeline marker N14°E 33.31'  
On Tree line running North & South

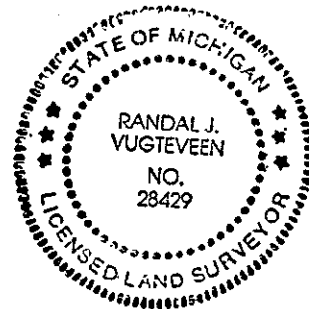

\$9.00 CORNER  
Receipt #19293

Signed by *Randal J. Vugteveen*  
Surveyor's Michigan License No. 28429

Date OCTOBER 19, 1998

\$1.00 PHOTO  
Receipt #19293