

SURVEY & REMONUMENTATION

FEB 27 1998

OTTAWA COUNTY REMONUMENTATION LAND CORNER RECORDATION CERTIFICATE Filing Requirement of Act 74, Mich. P.A. 1970

For corners in

OTTAWA
(County)

Located in: Corner Code #

- | | | |
|------------------------------------|---|--|
| 1. Public Land Survey | T <u>6N</u> R <u>13W</u> | B-13 S 1/4 cor.,
Sec.31,
Georgetown Twp. |
| | T <u> </u> R <u> </u> | |
| | T <u> </u> R <u> </u> | |
| | T <u> </u> R <u> </u> | |
| 2. Property Controlling in Section | S <u> </u> T <u> </u> R <u> </u> | |
| | S <u> </u> T <u> </u> R <u> </u> | |
| 3. Miscellaneous Property in Sec. | S <u> </u> T <u> </u> R <u> </u> | |
| | S <u> </u> T <u> </u> R <u> </u> | |

RECORDED

97 DEC -8 AM 11:30

Randy [Signature]
REGISTER OF DEEDS
OTTAWA COUNTY, MI

Register of Deeds Stamp & File Number

4. Lot No. _____, Recorded Plat _____
5. Private Claims _____

I, Randal J. Vugteveen, in a field survey on November 21, 1997 do hereby state that under requirements of P.A. 74, Michigan P.A. of 1970, the corner points mentioned in lines 1 and 2 above were in conformance with regulations and rules therefore as required in the current manual of survey instructions of the United States Department of the Interior, Bureau of Land Management or by a decree of a Court of Law and /or that the corner points mentioned in lines 3, 4 and 5 above were in conformance with the rules of the Michigan Board of Land Surveyors or by a Decree of a Court of Law, established, re-established, monumented, recovered, found as expressed below:

NOTE: Not more than 2 corners, all in the same town and range, may be recorded on this certificate.

	A	B	C	D	E	F	G	H	I	J	K	L	M
1													
2	6		5		4		3		2		1		
3													
4	7		8		9		10		11		12		
5													
6	18		17		16		15		14		13		
7													
8	19		20		21		22		23		24		
9													
10	30		29		28		27		26		25		
11													
12	31		32		33		34		35		36		
13													

A. Description of original monument and accessories and/or subsequent restoration:

B-13 G.L.O. survey notes 1838 R. Whitcomb Set post 10" Black Ash N43°E 10 links 7" Black Ash N67°W 12 links	L.C.R.C. Liber 2 Page 201 7-31-72 Found bolt spike Nail in side Telephone pole NE 59.0' Nail in side power pole WSW 67.77' Nail in side railroad crossing sign NE 38.12' Nail in side railroad crossing sign WNW 31.16' Nail in side power pole ESE 101.32'	L.C.R.C. Liber 2 Page 31 1-16-73 Found boat spike Telephone pole NE 59.0' Power pole WSW 67.75' Power pole ESE 101.35' Railroad sign WNW 31.22'
---	---	--


B. Description of corner evidence found and/or method applied in restoring or reestablishing corner:

B-13 Found boat spike in monument box Found tag & nail SW side power pole AZ 107° 101.04' Found tag & nail South side power pole AZ 247° 67.77'	Accepted position of boat spike as a careful perpetuation of the position of the original corner	Removed boat spike replaced with 3/4"x24" iron bar and Ottawa County Remon cap
---	--	--

P.A. 345 OTTAWA COUNTY
PEER APPROVED 12/1/97

C. Description of monument for corner and accessories established to perpetuate locating the position of the corner:

- B-13 - 3/4" X 24" iron bar with Ottawa County Remonumentation Cap
- Set Ottawa County Remon tag & nail West side power pole AZ 44° 42.90'
 - Set Ottawa County Remon tag & nail SW side power pole AZ 107° 101.19'
 - Set Ottawa County Remon tag & nail South side power pole AZ 247° 67.74'
 - SE bolt to base of railroad crossing AZ 292° 36.64'
 - Centerline East-West road South 5'
 - Centerline West bound M-21 S25°E 29.5'

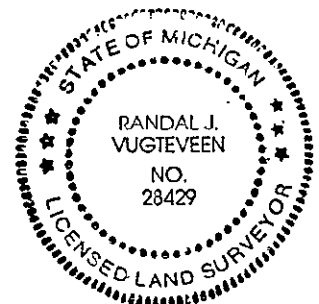

\$ 9.00 CORNER

Signed by *Randal J. Vugteveen*
Surveyor's Michigan License No. 28429

Date DEC 1, 1997