

SURVEY & REMONUMENTATION

DEC 01 1998

SECTION

**OTTAWA COUNTY REMONUMENTATION
LAND CORNER RECORDATION CERTIFICATE
Filing Requirement of Act 74, Mich. P.A. 1970**

For corners in

<u>Ottawa</u> (County)	Located In: Georgetown Township	Corner Code ## <u>C-1</u>
1. Public Land Survey	T <u>6N</u> R <u>13W</u>	<u>C-1</u>
	T _____ R _____	NW Corner
	T _____ R _____	Sec. 5
	T <u>7N</u> R <u>13W</u>	<u>C-13</u>
2. Property Controlling in Section	S _____ T _____ R _____	
	S _____ T _____ R _____	
3. Miscellaneous Property in Sec.	S _____ T _____ R _____	
	S _____ T _____ R _____	
4. Lot No. _____, Recorded Plat _____		
5. Private Claims _____		

RECORDED
98 JUL 24 PM 1:46

Ray S. Hillman
REGISTER OF DEEDS
OTTAWA COUNTY, MI

Register of Deeds Stamp & File Number

I, Rodney D. Unema, in a field survey on March 18, 19 98, do hereby certify that under requirements of P.A. 74, Michigan P.A. of 1970, the corner points mentioned in lines 1 and 2 above were in conformance with regulations and rules therefore as required in the current manual of survey instructions of the United States Department of the Interior, Bureau of Land Management or by a decree of a Court of Law and/or that the corner points mentioned in lines 3, 4 and 5 above were in conformance with the rules of the Michigan Board of Land Surveyors or by a Decree of a Court of Law; established, re-established, monumented, re-monumented, recovered, found as expressed below:

	A	B	C	D	E	F	G	H	I	J	K	L	A
2	6		5		4		3		2		1		
3													
4	7		8		9		10		11		12		
5													
6	18		17		16		15		14		13		
7													
8	19		20		21		22		23		24		
9													
10	30		29		28		27		26		25		
11													
12	31		32		33		34		35		36		
13													

NOTE: Not more than 4 corners, all in the same town and range, may be recorded on this certificate.

A. Description of original monument and accessories and/or subsequent restoration:

C-1 Corner is common to C-13 T7N, R13W, per G.L.O. notes and map, set post in 1837 by Lucius Lyon 8" Lyn N30°W 10 Lks 7" Sugar N57°E 25 Lks	O.C.R.C. Witnesses: M.B.T. SW 32.95' 10" Sycamore NW 69.6' St. sign N 14.25' P. Pole NW 77.5' *Common corner	(C-13, T7N, R13W) LCRC Liber 3, Page 347 T iron ¢ St. sign post N10°W 14.2' ¢ P. Pole N45°E 75.81' N. edge pavement S 11.55' on fence line to North
---	---	---

(over)

B. Description of corner evidence found and/or method applied in restoring or reestablishing corner:

C-1
Found 3/4" Steel bar with Ott. Co. Remon Cap
Found nail & O.C. tag in W side P. Pole N35°E 7.90'
Found Nail & O.C. tag in E side Tw. 6" tree N0°W 13.20'
¢ of Street sign N90°E 1.25'
N edge of pavement S0°E 11.7'


Accepted as a careful perpetuation of the position of the original corner

RA. 045 OTTAWA COUNTY
PEER APPROVED 4-20-98
J.D.U.

C. Description of monument for corner and accessories established to perpetuate locating the position of the corner:

C-1
3/4" X 2" steel bar with Ottawa Co. Remon. Cap
Nail & O.C. tag in W side P. Pole N35°E 7.90'
Nail & O.C. tag in E side Tw. 6" tree N0°W 13.20'
¢ of street sign N90°E 1.25'
N edge of pavement S0°E 11.7'
Set nail & O.C. Remon tag in NW side P. Pole N60°E 77.30'
Set nail & O.C. Remon. tag in E side 10" Elm N0°E 66.78'

Common with C-13, T7N, R13W

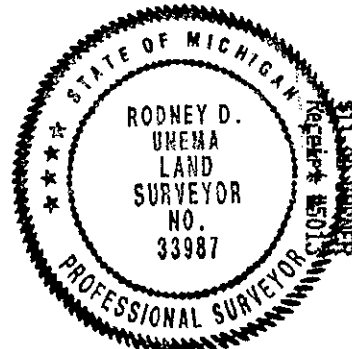

Signed by *Rodney D. Unema* Date April 20, 1998
Surveyor's Michigan License No. 33987

SURVEY &
REMONUMENTATION

DEC 01 1998

SECTION

C-13, T7N, R13W
Remon Lib. 3, Page 79 (Nov. 29, 1995)
3/4" X 2' steel bar with Ott. Co. Remon. cap
Set nail & O.C. Remon. tag in S side New pole
Set nail & O.C. Remon. tag in W side P. Pole N35°E 7.95'
¢ of street sign N90°E 1.25'
Set nail & O.C. Remon. tag in side 6" tw. tree N0°W 13.21'
North edge of bit. conc. pavement S0°E 11.75'