

**SURVEY &
REMONUMENTATION**

DEC 16 1996

COMMISSION

**OTTAWA COUNTY REMONUMENTATION
LAND CORNER RECORDATION CERTIFICATE
Filing Requirement of Act 74, Mich. P.A. 1970**

For corners in

OTTAWA

(County)

Located In:

Corner Code #

1. Public Land Survey

T 6N R 13W C-2 (E 1/4 corner of
Section 6)
Georgetown

2. Property Controlling
in Section

S T R

3. Miscellaneous
Property in Sec.

S T R
S T R

RECORDED

96 NOV 14 AM 11:19

Randy J. Vugteveen
REGISTER OF DEEDS
OTTAWA COUNTY, MI

Register of Deeds Stamp & File Number

4. Lot No. _____, Recorded Plat _____
5. Private Claims _____

I, Randal J. Vugteveen, in a field survey on August 22, 1996 do hereby state that under requirements of P.A. 74, Michigan P.A. of 1970, the corner points mentioned in lines 1 and 2 above were in conformance with regulations and rules therefore as required in the current manual of survey instructions of the United States Department of the Interior, Bureau of Land Management or by a decree of a Court of Law and /or that the corner points mentioned in lines 3, 4 and 5 above were in conformance with the rules of the Michigan Board of Land Surveyors or by a Decree of a Court of Law; established, re-established, monumented, recovered, found as expressed below:

1	A	B	C	D	E	F	G	H	I	J	K	L	M
2	6	5	4	3	2	1							
3													
4	7	8	9	10	11	12							
5													
6	10	17	16	15	14	13							
7													
8	19	20	21	22	23	24							
9													
10	30	29	28	27	26	25							
11													
12	31	32	33	34	35	36							
13													

NOTE: Not more than 2 corners, all in the same town and range, may be recorded on this certificate.

A. Description of original monument and accessories and/or subsequent restoration:

C-2 Common corner to Sections 5 & 6
1831 - Lyon
Set H.M.P.
Beech N34 E33 20 Links
Beech S24 W22 14 Links

Liber 2, Page 393
Found Stone and 1" Pipe
35.32' NE 22" Maple
E 16" Maple 25.78'
SE 41.82' 24" Maple
W 30.79' 18" Maple

(N.A.) SW cor. Sec. 5 S 2652.03' / (E.V. Peck Co. Surveyor 1867) NW cor. Sec. 5 N 2647.92' / (N.A.) NW cor. Sec. 5 N 2646.23'

B. Description of corner evidence found and/or method applied in restoring or reestablishing corner:

C-2 Found Iron in mon box 2' East of centerline 40th Avenue and accepted as a careful and faithful perpetuation of the position of the original corner


NW cor. Sec. 5 S. 2646.24'
SW cor. Sec. 5 N. 2652.01'

P.A. 345 OTTAWA COUNTY
PEER APPROVED 10-21-96
R. D. N.

C. Description of monument for corner and accessories established to perpetuate locating the position of the corner:

C-2 Removed Iron set 24" X 3/4" solid bar with Ottawa County Remon Cap in mon box

Set Ottawa County Remon Nail & Tag in SW corner pole barn siding Az. 50 deg 138.90'
Set Ottawa County Remon Nail & Tag in NW foundation cor garage #9182 Az. 144 deg 157.37'
Set Ottawa County Remon Nail & Tag in S side 20" Walnut Az. 95 deg. 41.23'
Set Ottawa County Remon Nail & Tag in N side 18" Walnut Az. 243 deg. 35.00'
Set Ottawa County Remon Nail & Tag in SE foundation cor garage #9191 Az. 221 deg. 104.06'

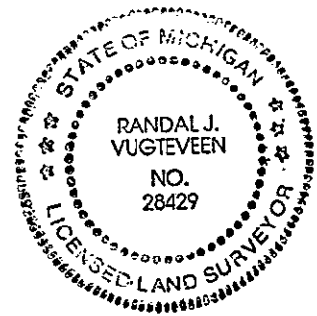

Signed by *Randal J. Vugteveen*
Surveyor's Michigan License No. 28429

Date SEPT 16, 1996