

**SURVEY &  
REMONUMENTATION**

DEC 1 6 1996

**COMMISSION**

**OTTAWA COUNTY REMONUMENTATION  
LAND CORNER RECORDATION CERTIFICATE  
Filing Requirement of Act 74, Mich. P.A. 1970**

For corners in  
OTTAWA  
(County)

Located In: Corner Code #

1. Public Land Survey	T <u>6N</u> R <u>13W</u>	C-3 (SE cor Section 6) Georgetown Twp.
	T <u>   </u> R <u>   </u>	
	T <u>   </u> R <u>   </u>	
	T <u>   </u> R <u>   </u>	
2. Property Controlling in Section	S <u>   </u> T <u>   </u> R <u>   </u>	
	S <u>   </u> T <u>   </u> R <u>   </u>	
3. Miscellaneous Property in Sec.	S <u>   </u> T <u>   </u> R <u>   </u>	
	S <u>   </u> T <u>   </u> R <u>   </u>	

**RECORDED**  
96 NOV 14 AM 11:19  
*[Signature]*  
REGISTER OF DEEDS  
OTTAWA COUNTY, MI  
**Register of Deeds Stamp & File Number**

4. Lot No. \_\_\_\_\_, Recorded Plat \_\_\_\_\_  
5. Private Claims \_\_\_\_\_

I, Randal J. Vugteveen, in a field survey on August 22, 1996 do hereby state that under requirements of P.A. 74, Michigan P.A. of 1970, the corner points mentioned in lines 1 and 2 above were in conformance with regulations and rules therefore as required in the current manual of survey instructions of the United States Department of the Interior, Bureau of Land Management or by a decree of a Court of Law and /or that the corner points mentioned in lines 3, 4 and 5 above were in conformance with the rules of the Michigan Board of Land Surveyors or by a Decree of a Court of Law; established, re-established, monumented, recovered, found as expressed below:

NOTE: Not more than 2 corners, all in the same town and range, may be recorded on this certificate.

	A	B	C	D	E	F	G	H	I	J	K	L	M
1													
2	6		5		4		3		2		1		
3													
4	7		8		9		10		11		12		
5													
6	18		17		16		15		14		13		
7													
8	19		20		21		22		23		24		
9													
10	30		29		28		27		26		25		
11													
12	31		32		33		34		35		36		
13													

**A. Description of original monument and accessories and/or subsequent restoration:**

C-3 Common corner to Sections 5, 6, 7 & 8  
1831 - Sibley  
Set post  
Elm N31 E11 9 Links  
Sugar S31 W25 14 Links

Liber 2, Page 493  
Found Pipe  
14" Maple East 54.15'  
16" Hickory ESE 38.64'  
15" Hickory SSE 122.60'

Liber 2, Page 393  
Found 1" pipe / E 14" Maple 54.14' / ESE 14"  
Hickory 38.62' / SSE 16" Hickory 22.65'  
(Kistler) S 1/4 cor Sec. 5 E 2678.31' / (Kistler) W  
1/4 cor Sec. 8 S 2652.04' / (C.P.C.) W 1/4 cor Sec.  
8 S 2651.78'

**B. Description of corner evidence found and/or method applied in restoring or reestablishing corner:**

C-3 Found rerod with cap in mon box on centerline 40th Avenue and accepted as a careful and faithful perpetuation of the position of the original corner

Found nail in N side Basswood Clump Az 46 deg  
43.49' / Found nail & washer in S side 14" Hickory  
Az 103 deg 38.30' / Found nail & washer S side 12"  
Pine Az 270 deg 39.42'


S 1/4 cor. Sec. 5 E 2678.16'  
W 1/4 cor. Sec. 8 S 2652.16'

P.A. 345 OTTAWA COUNTY  
PEER APPROVED 10-21-96  
*[Signature]*

**C. Description of monument for corner and accessories established to perpetuate locating the position of the corner:**

C-3 Removed Iron and set 3/4" X 24" solid bar with Ottawa County Remon Cap

Set Ottawa County Remon Nail & Tag in S side 12" Pine Az. 270 deg 39.44'  
Set Ottawa County Remon Nail & Tag in NE side 5" Twin Maple Az. 310 deg 49.14'  
Set Ottawa County Remon Nail & Tag in nW side 5" Hickory Az. 103 deg. 49.71'  
Set Ottawa County Remon Nail & Tag in S side 14" Hickory Az. 43 deg 38.36'

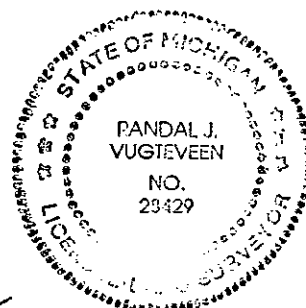

Signed by *[Signature]*  
Surveyor's Michigan License No. 23429

Date SEPT. 16, 1996