

1993

OTTAWA COUNTY REMONUMENTATION

RECORDED

COMMISSION

LAND CORNER RECORDATION CERTIFICATE  
Filing Requirement of Act 74, Mich. P.A. 1970

93 DEC 15 AM 9:26

For corners in **OTTAWA**

*Randy Bullman*  
REGISTER OF DEEDS  
OTTAWA COUNTY, MI

(County)	Located In:	Corner Code #
1. Public Land Survey	T <u>6N</u> R <u>13W</u>	C-6 (E 1/4 cor of Section 18) Georgetown Twp
	T _____ R _____	
	T _____ R _____	
	T _____ R _____	
2. Property Controlling in Section	S _____ T _____ R _____	
	S _____ T _____ R _____	
3. Miscellaneous Property in Sec.	S _____ T _____ R _____	
	S _____ T _____ R _____	

Register of Deeds Stamp & File Number

4. Lot No. \_\_\_\_\_, Recorded Plat \_\_\_\_\_  
5. Private Claims \_\_\_\_\_

	A	B	C	D	E	F	G	H	I	J	K	L	N
2	6		5		4		3		2				
3													
4	7		8		9		10		11		12		
5													
6	18		17		16		15		14		13		
7													
8	19		20		21		22		23		24		
9													
10	30		29		28		27		26		25		
11													
12	31		32		33		34		35		36		
13													

I, Randal J. Vugteveen, in a field survey on November 18, 1993, do hereby certify that under requirements of P.A. 74, Michigan P.A. of 1970, the corner points mentioned in lines 1 and 2 above were in conformance with regulations and rules therefore as required in the current manual of survey instructions of the United States Department of the Interior, Bureau of Land Management or by a decree of a Court of Law and/or that the corner points mentioned in lines 3, 4 and 5 above were in conformance with the rules of the Michigan Board of Land Surveyors or by a Decree of a Court of Law; established, re-established, monumented, re-monumented, recovered, found as expressed below:

**NOTE: Not more than 4 corners, all in the same town and range, may be recorded on this certificate.**

A. Description of original monument and accessories and/or subsequent restoration:

C-6 LCRC Liber 1, Page 483 Boatspike Nail in face 10" Hickory S55W 50.68' / Face of street sign post N10W 24.88' / Nail in face 32" Oak N60W 49.40' / Nail in face 36" Oak S50E 48.53'	C-6 LCRC Liber 1, Page 603 Nail in side 12" Hickory SW 51.48 / Nail in side 36" Oak SE 50.30 / Nail in side 30" Oak NW 50.35	C-6 LCRC Liber 3, Page 82 Cast Iron Mon. Fire hydrant N68E 56.82' 38" Oak S48E 50.85' 12" Hickory S54W 51.60' 32" Oak N58W 50.73' Fence to N W 0.6'
---	---	---


B. Description of corner evidence found and/or method applied in restoring or reestablishing corner:

C-6 Found broken CIM at centerline of 40th Avenue & Baldwin St. in mon box on tree ROW to North and accepted as a careful and faithful perpetuation of the position of the original corner Nail in face 10" Hicory S55W 51.42' Nail in face 36" Oak S50E 48.39'	Nail in side 36" Oak SE 50.30' Fnd PK in E side P.P. N 26.31'	Cast iron mon broken Fire hydrant N66E 56.77'
---	--	--

C. Description of monument for corner and accessories established to perpetuate locating the position of the corner:

C-6 Cast Iron Monument

- Set Ottawa County Remon Tag & Nail in E side P. P. N 26.31'
- Set Ottawa County Remon Tag & nail in SE side 12" Hickory S57W 51.42'
- Set Ottawa County Remon Tag & Nail in N side 38" Oak S56W 49.55'
- Top Cen. fire hydrant N66E 56.77'

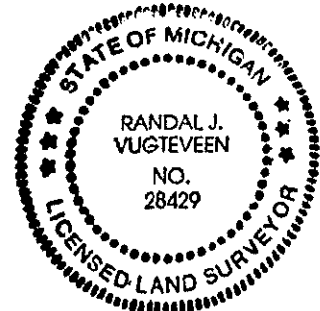

Signed by *Randal J. Vugteveen*

Date Dec 6, 1993

Surveyor's Michigan License No. 28429