

SURVEY & REMONUMENTATION

OTTAWA COUNTY REMONUMENTATION

APR 24 1995

RECORDED

LAND CORNER RECORDATION CERTIFICATE
Filing Requirement of Act 74, Mich. P.A. 1970

94 DEC 14 AM 9:41

COMMISSION

For corners in OTTAWA

D. J. Hallman
REGISTER OF DEEDS
OTTAWA COUNTY, MI

	(County)	Located In:	Corner Code #	
1. Public Land Survey	T	6N R 13W	C-8	(E 1/4 cor of Sec 19) Georgetown Twp.
	T	_____ R _____		
	T	_____ R _____		
	T	_____ R _____		
2. Property Controlling in Section	S	_____ T _____ R _____		
	S	_____ T _____ R _____		
3. Miscellaneous Property in Sec.	S	_____ T _____ R _____		
	S	_____ T _____ R _____		

Register of Deeds Stamp & File Number

4. Lot No. _____, Recorded Plat _____
5. Private Claims _____

	A	B	C	D	E	F	G	H	I	J	K	L	M
2	6	5	4	3	2	1							
3													
4	7	8	9	10	11	12							
5													
6	18	17	16	15	14	13							
7													
8	19	20	21	22	23	24							
9													
10	30	29	28	27	26	25							
11													
12	31	32	33	34	35	36							
13													

Randal J. Vugteveen, in a field survey on November 21, 1994, do hereby certify that under requirements of P.A. 74, Michigan P.A. of 1970, the corner points mentioned in lines 1 and 2 above were in conformance with regulations and rules therefore as required in the current manual of survey instructions of the United States Department of the Interior, Bureau of Land Management or by a decree of a Court of Law and/or that the corner points mentioned in lines 3, 4 and 5 above were in conformance with the rules of the Michigan Board of Land Surveyors or by a Decree of a Court of Law; established, re-established, monumented, re-monumented, recovered, found as expressed below:

NOTE: Not more than 4 corners, all in the same town and range, may be recorded on this certificate.

A. Description of original monument and accessories and/or subsequent restoration:


C-8 common corner to Sections 19 & 20		
1831 - Lyon & Sibley	Liber 1, Page 485	Liber 3, Page 82
Set H.M.P.	NW cor conc block bldg S25 $\frac{1}{2}$ E 70.55'	Cast Iron Mon
Pine 7" S79E 43 Links	NE cor conc gar fdn S40 $\frac{1}{2}$ W 116.89'	Fire hydrant N68 $\frac{1}{2}$ E 56.82'
B. Oak 14" N70W 27 Links	Nail in fac 28" Oak N45 $\frac{1}{2}$ W 47.84'	38" Oak S48 $\frac{1}{2}$ E 50.85'
	Nail in face 28" Maple N40 $\frac{1}{2}$ E 48.03'	12" Hickory S54 $\frac{1}{2}$ W 51.60'
		32" Oak N58 $\frac{1}{2}$ W 50.73'
		Fence to North W 0.6'

3. Description of corner evidence found and/or method applied in restoring or reestablishing corner:
C-8 Found broken CIM in mon box at centerline "X" 40th Ave. & Blair Street and accepted as a careful and faithful perpetuation and the position of the original corner
Nail in face 28" Maple N40E 49.05'

P.A. 345 OTTAWA COUNTY
PEER APPROVED 12/12/94
Wendy D. Nedeweld

C. Description of monument for corner and accessories established to perpetuate locating the position of the corner:

- C-8 Cast Iron Monument
- Set Ottawa County Remon Tag & Nail in NW side 36" Maple N35E 49.05'
 - Set Ottawa County Remon Tag & Nail in S side L. pole N83E 23.86'
 - Top hydrant S43E 58.37'
 - Set Ottawa County Remon Tag & Nail in E side 36" Oak N40W 48.87'
 - SE corner brick house #6815 N48W 107.28'
 - NE corner concrete garage foundation house #6785 S51W 106.27'

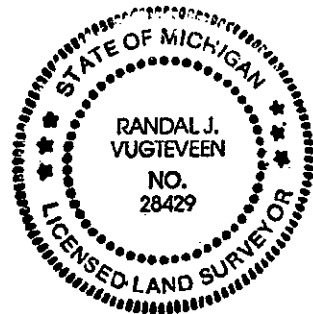

Signed by *Randal J. Vugteveen* Date Dec 12, 1994
Surveyor's Michigan License No. 28429