

**SURVEY & REMONUMENTATION**

DEC 01 1998

RECORDED

SECTION

Ottawa County Remonumentation  
**LAND CORNER RECORDATION CERTIFICATE**  
 Filing Requirement of Act 74, Mich. P.A. 1970

98 JUL 21 PM 12:14


For corners in

	<u>Ottawa</u> (County)	Located In:	Corner Code #
1. Public Land Survey		T <u>6N</u> R <u>13W</u>	<u>C-9 (SE, 19)</u> <u>Georgetown Twp.</u>
		T _____ R _____	_____
		T _____ R _____	_____
		T _____ R _____	_____
2. Property Controlling in Section	S _____	T _____ R _____	_____
	S _____	T _____ R _____	_____
3. Miscellaneous Property in Sec.	S _____	T _____ R _____	_____
	S _____	T _____ R _____	_____
4. Lot No. _____, Recorded Plat _____			
5. Private Claims _____			

*Harry Sheldon*  
 REGISTER OF DEEDS  
 OTTAWA COUNTY, MI

Register of Deeds Stamp & File Number

I, John C. Bueche, in a field survey on December 24, 19 97, do hereby certify that under requirements of P.A. 74, Michigan P.A. of 1970, the corner points mentioned in lines 1 and 2 above were in conformance with regulations and rules therefore as required in the current manual of survey instructions of the United States Department of the Interior, Bureau of Land Management or by a decree of a Court of Law and/or that the corner points mentioned in lines 3, 4 and 5 above were in conformance with the rules of the Michigan Board of Land Surveyors or by a Decree of a Court of Law; established, re-established, monumented, re-monumented, recovered, found as expressed below:

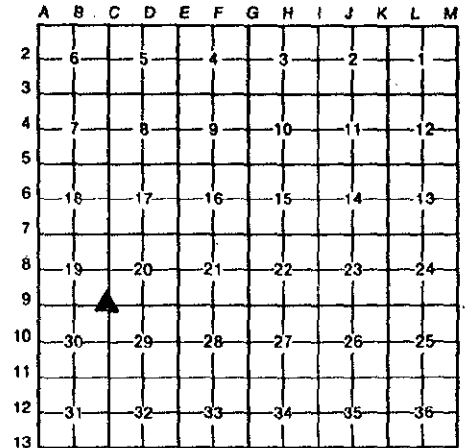

**NOTE: Not more than 4 corners, all in the same town and range, may be recorded on this certificate.**

A. Description of original monument and accessories and/or subsequent restoration:

C-9 GLO	LCRC L2, P203	Fnd. iron 6/8/97 before constr.
Lucius Lyon, 1831	Found bit. spk., June, 1973	Set iron NW 81.59' } same line
North between Secs. 29 & 30	24" Maple NE 42.73'	Set iron SE 112.93' } "
80.00' set post cor.	CPP NW 63.43'	Set iron NE 100.40' } same line
Secs. 19, 20, 29 & 30		Set iron SW 104.56' } "
Beech 6 N 42 E 30		
Beech 7 S 77 W 4 1/2		

B. Description of corner evidence found and/or method applied in restoring or reestablishing corner:

C-9 Found capped iron 6/8/97


Set mag. nail as per constr. wit.

And is accepted as a careful and faithful perpetuation of the position of the original corner.

PA. 345 OTTAWA COUNTY  
 PEER APPROVED 6-1-98  
*J.P.D.*

C. Description of monument for corner and accessories established to perpetuate locating the position of the corner:

C-9 Mag. nail  
 Set Mag. Nail in SW side UP N 33° W 64.23'  
 Set Mag. Nail in SW side UP S 45° E 62.79'  
 Set Mag. Nail in SE side UP S 20° W 101.73'  
 NW cor. hse. #3989 (foundation) N 34° E 125.29'  
 On C/L 40th Avenue & Port Sheldon Street  
 1.3' N of C/L MH

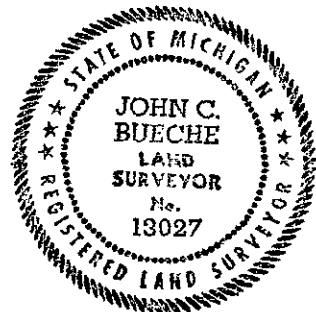

98.00 CORNER  
 Receipt #4453

Signed by John C. Bueche  
 John C. Bueche, P.S. 13027  
 Surveyor's Michigan License No.

Date 3-9-98