

# SURVEY & REMONUMENTATION

APR 24 1995

OTTAWA COUNTY REMONUMENTATION

RECORDED

COMMISSION

LAND CORNER RECORDATION CERTIFICATE

94 DEC 14 AM 10:02

Filing Requirement of Act 74, Mich. P.A. 1970

*Richard Hillman*  
REGISTER OF DEEDS  
OTTAWA COUNTY, MI

For corners in OTTAWA

(County)

Located In:

Corner Code #

- |                                    |                          |   |
|------------------------------------|--------------------------|---|
| 1. Public Land Survey              | T <u>6N</u> R <u>13W</u> | C-11 (SE cor of Section 30) Georgetown Twp. |
|                                    | T _____ R _____          | _____                                       |
|                                    | T _____ R _____          | _____                                       |
|                                    | T _____ R _____          | _____                                       |
| 2. Property Controlling in Section | S _____ T _____ R _____  | _____                                       |
|                                    | S _____ T _____ R _____  | _____                                       |
| 3. Miscellaneous Property in Sec.  | S _____ T _____ R _____  | _____                                       |
|                                    | S _____ T _____ R _____  | _____                                       |

Register of Deeds Stamp & File Number

4. Lot No. \_\_\_\_\_, Recorded Plat \_\_\_\_\_

5. Private Claims \_\_\_\_\_

	A	B	C	D	E	F	G	H	I	J	K	L	M
2	6	5	4	3	2	1							
3													
4	7	8	9	10	11	12							
5													
6	18	17	16	15	14	13							
7													
8	19	20	21	22	23	24							
9													
10	30	29	28	27	26	25							
11													
12	31	32	33	34	35	36							
13													

I, Randal J. Vugteveen, in a field survey on December 6, 1994, do hereby certify that under requirements of P.A. 74, Michigan P.A. of 1970, the corner points mentioned in lines 1 and 2 above were in conformance with regulations and rules therefore as required in the current manual of survey instructions of the United States Department of the Interior, Bureau of Land Management or by a decree of a Court of Law and/or that the corner points mentioned in lines 3, 4 and 5 above were in conformance with the rules of the Michigan Board of Land Surveyors or by a Decree of a Court of Law; established, re-established, monumented, re-monumented, recovered, found as expressed below:

**NOTE: Not more than 4 corners, all in the same town and range, may be recorded on this certificate.**

A. Description of original monument and accessories and/or subsequent restoration:  
C-11 Common corner to Sections 29, 30, 31 & 32


1831 - Lyon & Sibley	Liber 1, Page 751	Liber 2, Page 199
Set post in swamp	Nail in T. pole NW 53.31'	PK nail in side of T. pole NW 53.31'
B. Ash 10" N22E 23 Links	Nail in P. pole SE 44.31'	PK nail in side of T. pole NE 35.10'
Do 7" S1W 11 Links	Nail in T. pole NE 35.11'	PK nail in side of P. pole SE 44.32'
	Nail in P. pole WSW 57.27'	PK nail in side of P. pole SSE 78.88'
		PK nail in side of P. pole SW 57.30'

B. Description of corner evidence found and/or method applied in restoring or reestablishing corner:  
C-11 Found cut mark on manhole cover at centerline "X" 40th Ave & Van Buren Street and accepted as a careful and faithful perpetuation of the position of the original corner  
PK nail in side of T. pole NW 53.28'  
PK nail in side of P. pole SE 44.35'  
PK nail in side of P. pole SW 57.28'

P.A. 345 OTTAWA COUNTY  
DEED APPROVED 12/12/94  
*Kendrick P. Nedewell*

C. Description of monument for corner and accessories established to perpetuate locating the position of the corner:  
C-11 Cut mark on Manhole Cover

AZ = Michigan State Grid Direction  
Set PKs on edge of RIM N.S.E.W.  
SW foundation corner house #5618 AZ. 40 deg 106.96'  
NE corner brick garage #5617 AZ. 331 deg 166.77'  
NE corner brick house #4020 AZ. 240 deg 135.77'  
Set Ottawa County Remon Tag & Nail in NE side P. pole AZ. 126 deg 44.35'

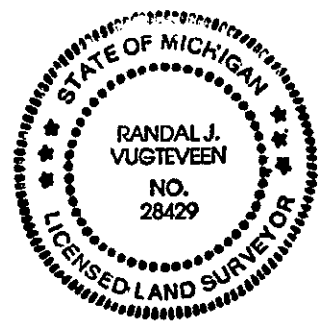

Signed by *Randal J. Vugteveen*  
Surveyor's Michigan License No. 28429

Date Dec 9, 1994