

# SURVEY & REMONUMENTATION

FEB 27 1998

## OTTAWA COUNTY REMONUMENTATION LAND CORNER RECORDATION CERTIFICATE Filing Requirement of Act 74, Mich. P.A. 1970

RECORDED

97 DEC -8 AM 11:41

*Randy Schultz*  
REGISTER OF DEEDS  
OTTAWA COUNTY, MI

Register of Deeds Stamp & File Number

For corners in SECTION  
OTTAWA

(County)

Located In: Corner Code #

- |                                       |                            |   |
|---------------------------------------|----------------------------|---|
| 1. Public Land Survey                 | T <u>6</u> N R <u>13</u> W | C-13, SE cor.,<br>Sec. 31,<br>Georgetown Twp. |
|                                       | T ___ R ___                | _____   |
|                                       | T ___ R ___                | _____   |
|                                       | T ___ R ___                | _____   |
| 2. Property Controlling<br>in Section | S ___ T ___ R ___          | _____   |
|                                       | S ___ T ___ R ___          | _____   |
| 3. Miscellaneous<br>Property in Sec.  | S ___ T ___ R ___          | _____   |
|                                       | S ___ T ___ R ___          | _____   |

4. Lot No. \_\_\_\_\_, Recorded Plat \_\_\_\_\_  
5. Private Claims \_\_\_\_\_

I, Randal J. Vugteveen, in a field survey on November 21, 19 97 do hereby state that under requirements of P.A. 74, Michigan P.A. of 1970, the corner points mentioned in lines 1 and 2 above were in conformance with regulations and rules therefore as required in the current manual of survey instructions of the United States Department of the Interior, Bureau of Land Management or by a decree of a Court of Law and/or that the corner points mentioned in lines 3, 4 and 5 above were in conformance with the rules of the Michigan Board of Land Surveyors or by a Decree of a Court of Law; established, re-established, monumented, recovered, found as expressed below:

**NOTE:** Not more than 2 corners, all in the same town and range, may be recorded on this certificate.

	A	B	C	D	E	F	G	H	I	J	K	L
1												
2	6		5		4		3		2		1	
3												
4	7		8		9		10		11		12	
5												
6	10		17		16		15		14		13	
7												
8	19		20		21		22		23		24	
9												
10	30		29		28		27		26		25	
11												
12	31		32		33		34		35		36	
13												

**A. Description of original monument and accessories and/or subsequent restoration:**

C-13 GLO survey notes Oct. 1838 R. Whitcomb Set post 4" beech N28°W 21 links 10" beech N82°E 43 links	L.C.R.C. Liber 2 Page 201 7-19-72 1" iron Nail in power pole NNW 66.60' Nail in power pole SW 39.87' Nail in 36" maple NE 67.93' SW corner house NE 113.66'	L.C.R.C. Liber 5 Page 40 3-17-83 Found T iron PK in East side power pole NNE 66.50' PK in North side power pole SW 39.52' Spike in North side power pole SE 42.16' Capped iron East 25.09'
--	--	---

**NOTE:** (see back for additional information)

**B. Description of corner evidence found and/or method applied in restoring or reestablishing corner:**

C-13 Found Iron bar with Ottawa County Remon cap in monument box


Found PK in bit. East 60.70' Found SE corner back of catch basin S65°E 50.00' Found NE corner back of catch basin S40°E 36.26' Found capped iron in monument box East 25.08' (C-1, 5-13)	Accepted position of iron bar with Ottawa County Remon cap as a careful perpetuation of the position of the original corner
---	---

P.A. 345 OTTAWA COUNTY  
PEEP  
12/1/97  
*YDN*

**C. Description of monument for corner and accessories established to perpetuate locating the position of the corner:**

C-13 Iron bar with Ottawa County Remonumentation cap in monument box

- SW corner house # 4810 AZ 48° 113.62'
- Found capped iron in monument box East 25.08'
- Set Ottawa County Remon tag & nail in SW side power pole AZ 133° 42.10'
- Set Ottawa County Remon tag & nail in NW side power pole/light pole AZ 228° 39.84'
- Found Ottawa County Remon tag & nail in NE side power pole AZ 336° 66.47'
- On centerline of road to North
- On centerline of East-West road

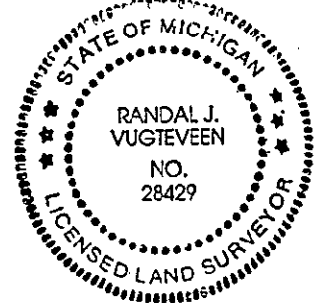

\$ 11.00 CORNER  
\$ 2.00 PHOTO

Signed by *Randal J. Vugteveen*  
Surveyor's Michigan License No. 28429

Date Dec. 1, 1997

L.C.R.C. Liber 6, Page 20

12-1-89

SE corner back of catch basin S65°E 50.01'

NE corner back of catch basin N70°E 49.44'

South corner back of catch basin S40°E 36.28'

Corner concrete South line drive & East line walk N30°E 65.53'

PK in bit. East 60.72'

Iron in monument box (C-1, 5-13) East 25.11'

**SURVEY &  
REMONUMENTATION**

**FEB 27 1998**

**SECTION**