

OTTAWA COUNTY REMONUMENTATION

RECORDED

93 DEC 15 AM 9:26

COMMISSION

LAND CORNER RECORDATION CERTIFICATE

Filing Requirement of Act 74, Mich. P.A. 1970

For corners in OTTAWA

(County)

Located In:

Corner Code #

- 1. Public Land Survey T 6N R 13W D-7 (S 1/4 cor Section 17) Georgetown Twp
- 2. Property Controlling S \_\_\_\_\_ T \_\_\_\_\_ R \_\_\_\_\_
- in Section S \_\_\_\_\_ T \_\_\_\_\_ R \_\_\_\_\_
- 3. Miscellaneous S \_\_\_\_\_ T \_\_\_\_\_ R \_\_\_\_\_
- Property in Sec. S \_\_\_\_\_ T \_\_\_\_\_ R \_\_\_\_\_

*D. J. Vugteveen*  
REGISTER OF DEEDS  
OTTAWA COUNTY, MI

Register of Deeds Stamp & File Number

- 4. Lot No. \_\_\_\_\_, Recorded Plat \_\_\_\_\_
- 5. Private Claims \_\_\_\_\_

	A	B	C	D	E	F	G	H	I	J	K	L	M
2	6		5		4		3		2		1		
3													
4	7		8		9		10		11		12		
5													
6	18		17		16		15		14		13		
7													
8	19		20		21		22		23		24		
9													
10	30		29		28		27		26		25		
11													
12	31		32		33		34		35		36		
13													

I, Randal J. Vugteveen, in a field survey on November 18, 1993, do hereby certify that under requirements of P.A. 74, Michigan P.A. of 1970, the corner points mentioned in lines 1 and 2 above were in conformance with regulations and rules therefore as required in the current manual of survey instructions of the United States Department of the Interior, Bureau of Land Management or by a decree of a Court of Law and/or that the corner points mentioned in lines 3, 4 and 5 above were in conformance with the rules of the Michigan Board of Land Surveyors or by a Decree of a Court of Law; established, re-established, monumented, re-monumented, recovered, found as expressed below:

**NOTE: Not more than 4 corners, all in the same town and range, may be recorded on this certificate.**

A. Description of original monument and accessories and/or subsequent restoration:

D-7 LCRC Liber 1, Page 465	D-7 LCRC Liber 5, Page 255
Bt spike 3' W of centerline road	Set CIM
1" Irons E & W 33'	PP E 54.58'
NW cor hse S35E 138.23'	9" tree ENE 36.23'
CP pole S85E 54.54'	5" tree W 23.68'
On fence line W	12" Maple SE 103.44'

B. Description of corner evidence found and/or method applied in restoring or reestablishing corner:


D-7 Found broken CIM 3' W of centerline of 36th Street tree ROW E & W and accepted as a careful and faithful perpetuation of the position of the original corner

NW cor hse S35E 138.02'	Pp E 54.61'
CP pole S85E 54.61'	5" tree W 23.55'
	12" Maple SE 103.10'

C. Description of monument for corner and accessories established to perpetuate locating the position of the corner:

D-7 Cast Iron Monument

- Set Ottawa County Remon Tag & Nail S side P. Pole S85E 54.61'
- Set Ottawa County Remon Tag & Nail W side 12" Maple S29E 103.10'
- NW cor brk hse #7180 S33'E 138.02'
- Set Ottawa County Remon Tag & Nail S side 10" Treet N81W 23.55'
- SE brk cor garage N73W 105.08'

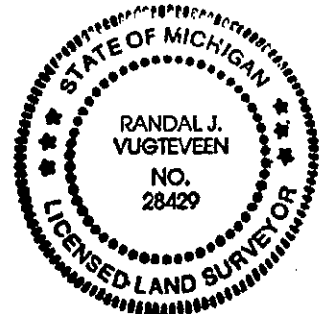

Signed by *Randal J. Vugteveen*

Date Dec 6, 1993

Surveyor's Michigan License No. 28429