

**SURVEY & REMONUMENTATION**

APR 05 1996

OTTAWA COUNTY REMONUMENTATION

RECORDED

COMMISSION

LAND CORNER RECORDATION CERTIFICATE 95 DEC 19 PM 4:42  
Filing Requirement of Act 74, Mich. P.A. 1970

For corners in  
OTTAWA  
(County)

Located In: Corner Code #

*D. J. Vugteveen*  
REGISTER OF DEEDS  
OTTAWA COUNTY, MI

- |                                    |        |                           |
|------------------------------------|--------|---------------------------|
| 1. Public Land Survey              | 6N 43W | D-9 (S 1/4 cor of Sec 20) |
|                                    | T R    | Georgetown Twp.           |
|                                    | T R    |                           |
|                                    | T R    |                           |
| 2. Property Controlling in Section | S T R  |                           |
|                                    | S T R  |                           |
| 3. Miscellaneous Property in Sec.  | S T R  |                           |
|                                    | S T R  |                           |

Register of Deeds Stamp & File Number

4. Lot No. \_\_\_\_\_, Recorded Plat \_\_\_\_\_  
5. Private Claims \_\_\_\_\_

	A	B	C	D	E	F	G	H	I	J	K	L
2	6	5	4	3	2	1						
3												
4	7	8	9	10	11	12						
5												
6	13	17	16	15	14	13						
7												
8	19	20	21	22	23	24						
9												
10	30	29	28	27	26	25						
11												
12	31	32	33	34	35	36						
13												

I, Randal J. Vugteveen, in a field survey on November 21, 19 94, do hereby certify that under requirements of P.A. 74, Michigan P.A. of 1970, the corner points mentioned in lines 1 and 2 above were in conformance with regulations and rules therefore as required in the current manual of survey instructions of the United States Department of the Interior, Bureau of Land Management or by a decree of a Court of Law and/or that the corner points mentioned in lines 3, 4 and 5 above were in conformance with the rules of the Michigan Board of Land Surveyors or by a Decree of a Court of Law; established, re-established, monumented, re-monumented, recovered, found as expressed below:

**NOTE: Not more than 4 corners, all in the same town and range, may be recorded on this certificate.**

**A. Description of original monument and accessories and/or subsequent restoration:**

D-9 common corner to Sections 20 & 29

1831 - Lyon & Sibley	Liber 2, Page 447	Liber 2, Page 203
Set 1/4 Section post	NE cor hse fnd S65°W 60.05'	10" Pine NNE 89.15'
Beech 6" S45W 20 Links	NW cor gar brick S70°E 106.34'	14" Maple NE 96.95'
Op 10" N77E 32 Links	8" pipe N20°E 89.60'	

**B. Description of corner evidence found and/or method applied in restoring or reestablishing corner:**

D-9 Found PK nail in 7' W of centerline 36th Ave. 570' S of centerline Port Sheldon St., and accepted as a careful and faithful perpetuation of the position of the original corner


NE cor hse fnd S651/2W 60.00'	10" line NNE 89.15'	PP N66W 31.18'
NW cor gar brick S701/2E 106.30'	28" Maple N60E 97.8'	12" Pine N22E 89.84'
8" Pine N201/2E 89.60'		13" Pine N56E 39.53'
		PP N79E 40.49'

P.A. 345 OTTAWA COUNTY  
PEER APPROVED 12/11/95  
*Randy D. Newell*

**C. Description of monument for corner and accessories established to perpetuate locating the position of the corner:**

D-9 Replaced PK with 3/4" x 3' steel bar with Ottawa County Remonumentation cap and placed monument box

NE corner foundation house #6385 S59W 60.00  
NW corner brick garage house #6382 S68E 106.30'  
SE brick house #6391 N62W 55.42'  
Top hydrant S13E 137.33'

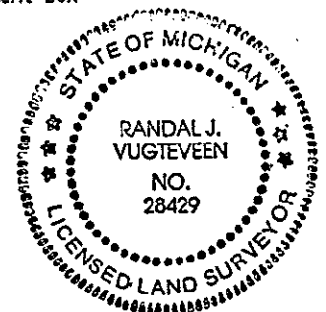

Signed by *Randal J. Vugteveen*  
Surveyor's Michigan License No. 28429

Date Dec 11, 1995