

SURVEY & REMONUMENTATION

APR 24 1995

COMMISSION

OTTAWA COUNTY REMONUMENTATION

LAND CORNER RECORDATION CERTIFICATE
Filing Requirement of Act 74, Mich. P.A. 1970

RECORDED

94 DEC 14 AM 10:02

Daphne Robinson
REGISTER OF DEEDS
OTTAWA COUNTY, MI

For corners in OTTAWA
(County)

	Located In:	Corner Code #
1. Public Land Survey	T <u>6N</u> R <u>13W</u>	D-11 (S 1/4 cor Section 29) Georgetown Twp.
	T _____ R _____	_____
	T _____ R _____	_____
2. Property Controlling in Section	S _____ T _____ R _____	_____
	S _____ T _____ R _____	_____
3. Miscellaneous Property in Sec.	S _____ T _____ R _____	_____
	S _____ T _____ R _____	_____

Register of Deeds Stamp & File Number

4. Lot No. _____, Recorded Plat _____
5. Private Claims _____

	A	B	C	D	E	F	G	H	I	J	K	L	M
2	6	5	4	3	2	1							
3													
4	7	8	9	10	11	12							
5													
6	18	17	16	15	14	13							
7													
8	19	20	21	22	23	24							
9													
10	30	29	28	27	26	25							
11													
12	31	32	33	34	35	36							
13													

I, Randal J. Vugteveen, in a field survey on December 6, 1994, do hereby certify that under requirements of P.A. 74, Michigan P.A. of 1970, the corner points mentioned in lines 1 and 2 above were in conformance with regulations and rules therefore as required in the current manual of survey instructions of the United States Department of the Interior, Bureau of Land Management or by a decree of a Court of Law and/or that the corner points mentioned in lines 3, 4 and 5 above were in conformance with the rules of the Michigan Board of Land Surveyors or by a Decree of a Court of Law; established, re-established, monumented, re-monumented, recovered, found as expressed below:

NOTE: Not more than 4 corners, all in the same town and range, may be recorded on this certificate.

A. Description of original monument and accessories and/or subsequent restoration:
D-11 Common corner to Sections 29 & 32

1831 - Lyon & Sibley
Elm is corner
No witnesses

Liber 1, Page 739
SW cor hse fndn. NE 84.40'
Nail in P. pole SW 44.90'
NW cor hse fndn. SE 76.70'
Corner falls on W edge of M.H.

Liber 1, Page 751
SW cor hse fndn NE 84.40'
Nail in P. Pole SW 44.90'
NW cor hse fndn SE 76.70'

3. Description of corner evidence found and/or method applied in restoring or reestablishing corner:
D-11 Found MH at centerline "X" 36th Ave & Van Buren Street, found cut mark on W edge of RIM and accepted as a careful and faithful perpetuation of the position of the original corner

SW cor hse fndn NE 84.42'
Nail in P. pole SW 44.85'
NW cor hse fndn SE 76.66'

SW cor hse fndn NE 84.42'
Nail in P. pole SW 44.85'
NW cor hse fndn SE 76.66'
Corner falls on W edge of MH


P.A. 345 OTTAWA COUNTY

RECORDED 12/12/94

Randal J. Vugteveen

C. Description of monument for corner and accessories established to perpetuate locating the position of the corner:
D-11 Found cut mark on West edge of RIM

AZ = Michigan State Grid Direction
Set Ottawa County Remon Tag & Nail in SW side 24" Maple AZ. 327 deg 46.55'
SW corner house foundation #3593 AZ. 42 deg 84.42'
NW corner house foundation #3598 AZ. 145 deg 76.66'
Set Ottawa County Remon Tag & Nail in SE side P. pole AZ. 237 deg 44.86'

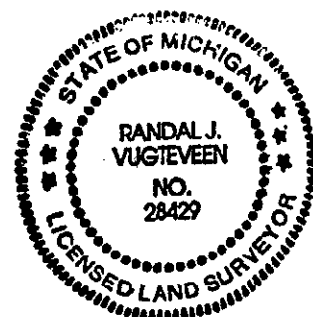

Signed by Randal J. Vugteveen
Surveyor's Michigan License No. 28429

Date Dec 9, 1994