

APR 05 1996

COMMISSION

OTTAWA COUNTY REMONUMENTATION

LAND CORNER RECORDATION CERTIFICATE
Filing Requirement of Act 74, Mich. P.A. 1970

For corners in
OTTAWA
(County)

Located In: Corner Code #

- 1. Public Land Survey T6N R13W E-3 (SE 1/4 cor Section 5) Georgetown Twp.
- 2. Property Controlling in Section S T R
- 3. Miscellaneous Property in Sec. S T R

RECORDED

95 NOV 15 PM 2:12

D. J. ...
REGISTER OF DEEDS
OTTAWA COUNTY, MI

Register of Deeds Stamp & File Number

- 4. Lot No. _____, Recorded Plat _____
- 5. Private Claims _____

A	B	C	D	E	F	G	H	I	J	K	L
2	6	5	4	3	2	1					
3											
4	7	8	9	10	11	12					
5											
6	18	17	16	15	14	13					
7											
8	19	20	21	22	23	24					
9											
10	30	29	28	27	26	25					
11											
12	31	32	33	34	35	36					
13											

I, Randal J. Vugteveen, in a field survey on October 10, 19 95, do hereby certify that under requirements of P.A. 74, Michigan P.A. of 1970, the corner points mentioned in lines 1 and 2 above were in conformance with regulations and rules therefore as required in the current manual of survey instructions of the United States Department of the Interior, Bureau of Land Management or by a decree of a Court of Law and/or that the corner points mentioned in lines 3, 4 and 5 above were in conformance with the rules of the Michigan Board of Land Surveyors or by a Decree of a Court of Law; established, re-established, monumented, re-monumented, recovered, found as expressed below:

NOTE: Not more than 4 corners, all in the same town and range, may be recorded on this certificate.

A. Description of original monument and accessories and/or subsequent restoration:

E-3 Common corner to Sections 4, 5, 8 & 9

- | | | |
|-------------------------|-----------------------|---|
| 1831 - Sibley | Liber 2, Page 307 | Liber 1, Page 189 |
| Set post | Found Iron Pipe | 1 1/2" iron found in centerline road on |
| Beech S39 W14 7 Links | 24" Hickory NE 54.42' | tree lines N & S |
| W. Ash N24 E23 20 Links | 30" Oak S 20.30' | 24" Hickory N78E 54.40' |
| | 8" Oak N 39.89' | 8" Hickory N 5 deg 30'E 28.77' |
| | T. pole NE 79.61' | 6" Oak S27W 40.0' |
| | | 32" Oak S7 deg 30'W 20.45' |

B. Description of corner evidence found and/or method applied in restoring or reestablishing corner:


E-3 Found 3/4" pipe on centerline Taylor and centerline treeline N&S and accepted as a careful and faithful perpetuation of the position of the original corner
Nail N side 24" Hickory 44.30'
Nail W side 30" Oak 21.93'

P.A. 345 OTTAWA COUNTY
PEER APPROVED 10/23/95
Randal J. Vugteveen
RD 7

C. Description of monument for corner and accessories established to perpetuate locating the position of the corner:

E-3 Set 3/4" x 36" solid bar with Ottawa County Remon Cap

- Set Ottawa County Remon Nail & Tag on N side 24" Hickory Az. 75 deg 55.30'
- Set Ottawa County Remon Nail & Tag on W die 40" Oak Az. 193 deg 21.40'
- Set Ottawa County Remon Nail & Tag on E side 12" Oak Az. 319 deg 28.51'
- NW block foundation corner house #3210 Taylor Az. 160 deg 106.33'
- NE block foundation corner garage #3210 Taylor Az. 138 deg 140.60'

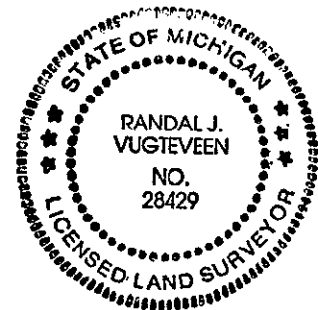

Signed by *Randal J. Vugteveen*
Surveyor's Michigan License No. 28429

Date Oct. 20, 1995